



STREET	TIME	NORTHBOUND	SOUTHBOUND	EASTBOUND	WESTBOUND
GRINDING, PAVING, CONCRETE STREET, & BASE REPAIR WORK					
<u>PERALTA AVENUE</u>					
Mullen Ave to Franconia St	8AM – 4PM (M-F) At Other Times	- -	- -	1@10' Full Rdwy	1@10' Full Rdwy
<u>Cross Streets for Peralta Ave</u>					
Franconia St ↓	8AM – 4PM (M-F) At Other Times	1@10' Reversible Full Rdwy		- -	- -

REPLACE OPEN TRENCH SIGNS WITH SIGNS APPROPRIATE FOR THE WORK ACTIVITY:

EXISTING SIGN	REPLACEMENT SIGN
 C27 OPEN TRENCH	 C43(GA) FRESH CONCRETE
CONCRETE STREET BASE DEMO	PLACING CONCRETE STREET BASE



R9-3a R9-3bR

MULLEN AVE

MONTCALM ST

R9-3a R9-3b


☒ NO EXCEPTIONS TAKEN
☒ MAKE CORRECTIONS NOTED
☒ REJECTED
☒ REVISE AND RESUBMIT
☒ SUBMIT SPECIFIED ITEM(S)

Review is only for general performance with the design concept of the project and general compliance with the requirements of the contract documents. Any action shown is based on the requirements of the plans and specifications. Contractor's responsibilities include, which are not limited to actual dimensions but shall be confirmed and correlated to the approved and preferred fabrication processes and techniques of construction; coordination of the contractor's work with that of all other trades; and the satisfactory performance of the contractor's work.

Sustainable Streets Division
 San Francisco Municipal Transportation Agency
 City and County of San Francisco

By: *Justin Hui* Date: *7/27/22*

Revisions				
No.	Revisions	By	Date	Appr

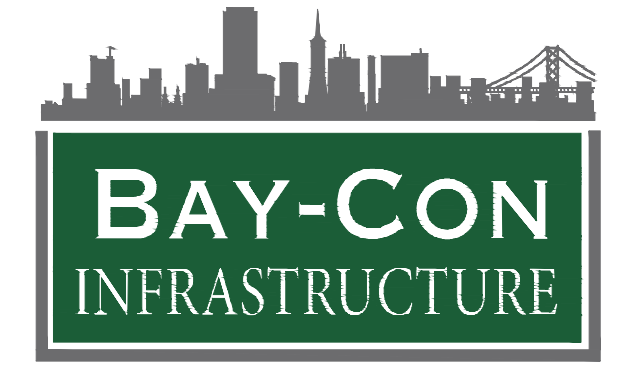

BAY-CON INFRASTRUCTURE
PO BOX 1342
SAN MATEO CA 94401
(415) 580-1441 OFFICE
(415) 329-3240 FAX
INFO@BAY-CON.COM

Key Plan

This document is the property of the engineer and is not to be used without engineer's written permission. Satellite imagery provided by Google Earth.

Engineer Of Record:
PHIL MIESZKOWSKI, PE



DESIGN DOCUMENTS
TEMPORARY TRAFFIC CONTROL

Client
MICHAEL O'SHAUGHNESSY CONSTRUCTION, INC
48 RIVERTON DR
SAN FRANCISCO, CA 94132
(415) 726-3052
OFFICE@MOSCONSTRUCTION.ORG

Owner
SAN FRANCISCO PUBLIC WORKS
48 S VAN NESS AVE, SUITE 1600
SAN FRANCISCO, CA 94103
(628) 271-3139
CONTRACTADMIN.STAFF@SFPD.W.ORG

Project
VARIOUS LOCATIONS NO. 52 PAVEMENT
RENOVATION AND SEWER REPLACEMENT
SAN FRANCISCO, CA
SOURCING ID NO. 0000003758

Sheet Title
TCP FOR CONCRETE STREET BASE REPAIR
ON PERALTA AVE AT FRANCONIA ST - SE
QUADRANT - SHEET 33 OF 46

BCI Job 146

Drwn By PM

Chckd By PM

Issue Date 05/20/2022

TCP-075