


Traffic Lane Requirements  
Number and Width of Lanes

STREET	TIME	NORTHBOUND	SOUTHBOUND	EASTBOUND	WESTBOUND
SEWER MAIN WORK					
PERALTA AVENUE					
Mullen Ave intersection ↓	8AM – 4PM (M-F) At Other Times	1@10' Reversible↓ Full Rdwy		-	-
Cross Streets for Peralta Ave					
Mullen Ave ↑	8AM – 4PM (M-F) At Other Times	-	-	1@10' Reversible↑ Full Rdwy	
Florida St	At All Times	Full Rdwy	Full Rdwy	-	-

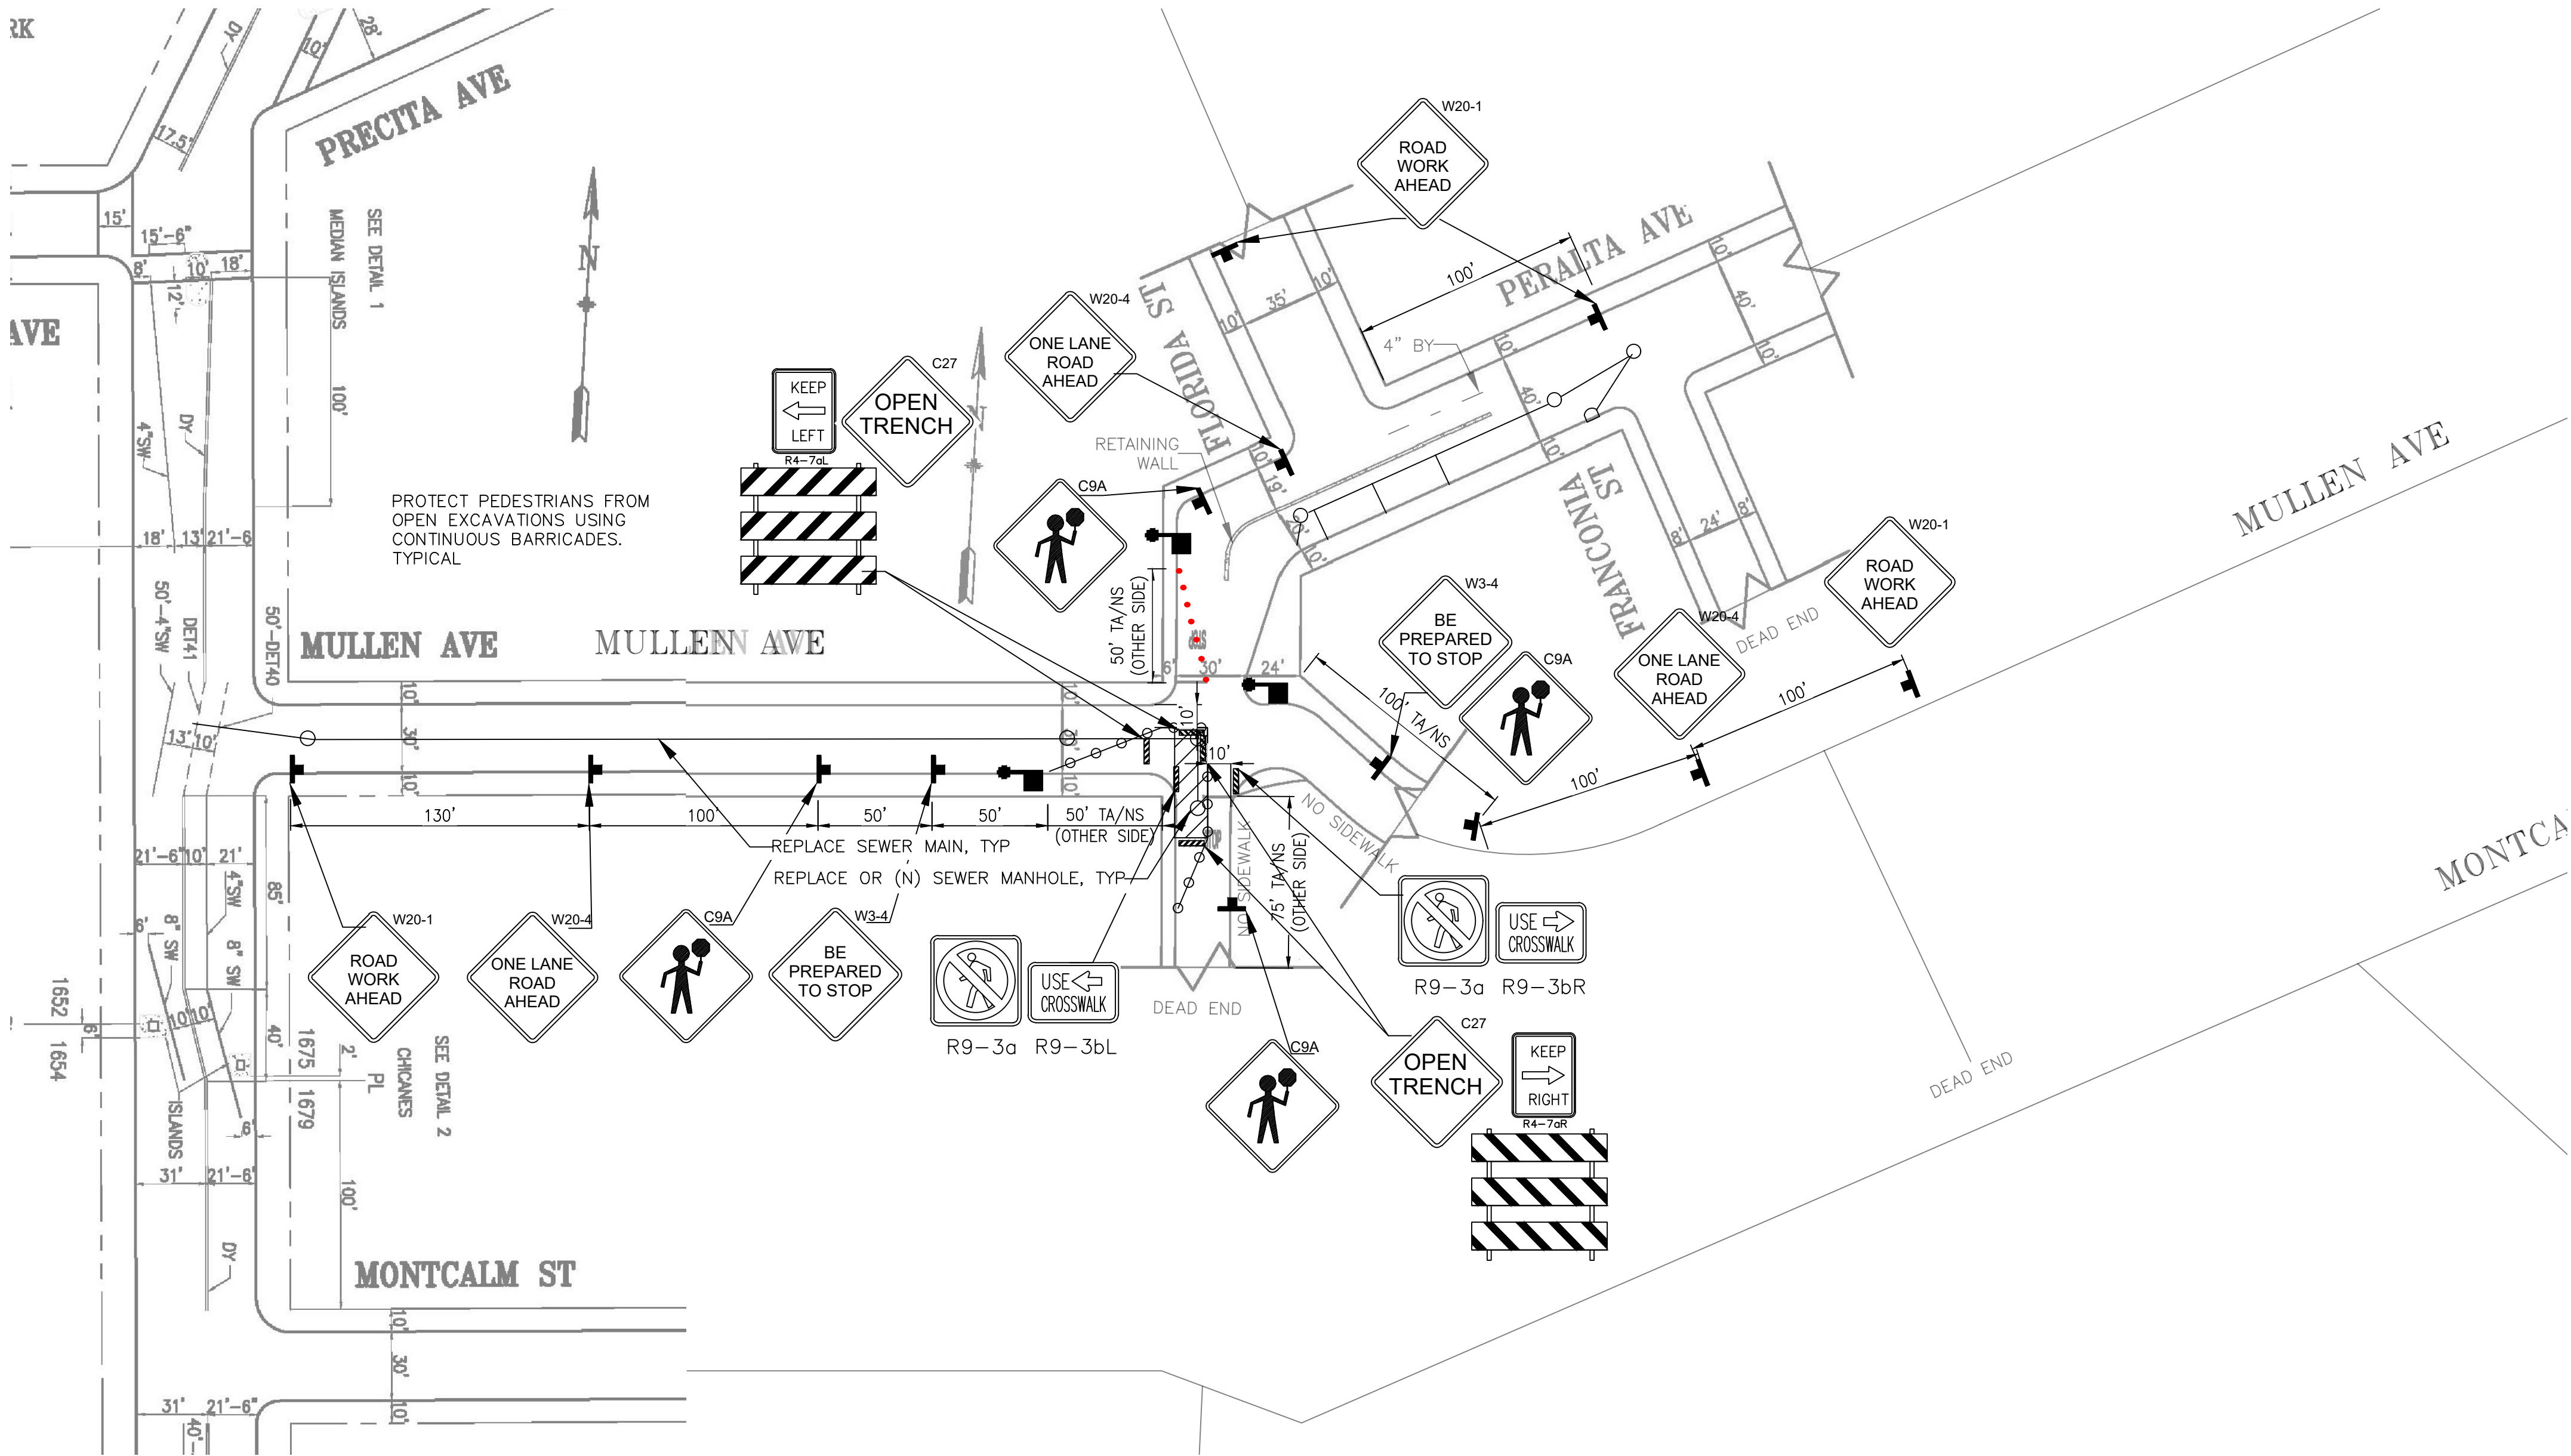


☐ NO EXCEPTIONS TAKEN  
☒ MAKE CORRECTIONS NOTED  
☐ REJECTED  
☐ REVISE AND RESUBMIT  
☐ SUBMIT SPECIFIED ITEM(S)

Review is only for general conformance with the design concept of the project and general compliance with the requirements of the contract documents. Any action shown is subject to the requirements of the plans and specifications. Contractor's responsibilities include, but are not limited to actual dimensions which shall be confirmed and correlated at the job site; preferred fabrication processes and techniques of construction; coordination of the contractor's work with that of all other trades; and the satisfactory performance of the contractor's work.

Sustainable Streets Division  
San Francisco Municipal Transportation Agency  
City and County of San Francisco

By: *[Signature]* Date: 4/29/22

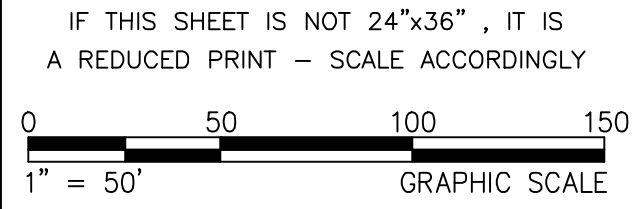

Revisions		By	Date	Appr.
No.	Revisions			

BAY-CON INFRASTRUCTURE  
PO BOX 1342  
SAN MATEO CA 94401  
(415) 580-1441 OFFICE  
(415) 329-3240 FAX  
INFO@BAY-CON.COM

Key Plan

This document is the property of the engineer and is not to be used without engineer's written permission. Satellite imagery provided by Google Earth.

Engineer Of Record:  
PHIL MIESZKOWSKI, PE

3/14/2022

DESIGN DOCUMENTS  
TEMPORARY TRAFFIC CONTROL

Client  
MICHAEL O'SHAUGHNESSY CONSTRUCTION, INC  
48 RIVERTON DR  
SAN FRANCISCO, CA 94132  
(415) 726-3052  
OFFICE@MOSCONSTRUCTION.ORG

Owner  
SAN FRANCISCO PUBLIC WORKS  
49 S VAN NESS AVE, SUITE 1600  
SAN FRANCISCO, CA 94103  
(628) 271-3139  
CONTRACTADMIN.STAFF@SFPD.W.ORG

Project  
VARIOUS LOCATIONS NO. 52 PAVEMENT  
RENOVATION AND SEWER REPLACEMENT  
SAN FRANCISCO, CA  
SOURCING ID NO. 0000003758

Sheet Title  
TEMPORARY TRAFFIC CONTROL PLAN FOR  
SEWER MAIN AND MANHOLE CONSTRUCTION  
ON PERALTA AVE AT MULLEN ST

BGI Job 146	Sheet TCP-023
Drwn By PM	
Chckd By PM	
Issue Date 3/14/2022	