


STREET	TIME	NORTHBOUND	SOUTHBOUND	EASTBOUND	WESTBOUND
SEWER LINING WORK					
30TH STREET					
San Jose Ave to Mission St *(MC,TC)	9AM – 3PM (M-F) At Other Times	- -	- -	1@12' Full Rdwy	1@12' Full Rdwy
<u>Cross Streets for 30th Street</u>					
San Jose Ave β *(MM) Mission St *(MC, TC)	At All Times	Full Rdwy	Full Rdwy	-	-

Location	Description of Transit Support Required	Muni Inspectors Required	Contractor Personnel Required to Detach/Reattach Poles to OCS* *also referred to as Pole/De-pole
30 th Street, between Mission Street and San Jose Avenue	During manhole construction and side sewer work, Muni overhead wires in the eastbound and westbound direction will be de-energized and Muni will run on battery power along the block. The work requiring the de-energizing of the overhead Muni wires shall be limited to four (4) weekdays. Muni overhead wires will be reenergized at the end of every work day.	One (1) for a maximum of four (4) weekdays.	Two (2).

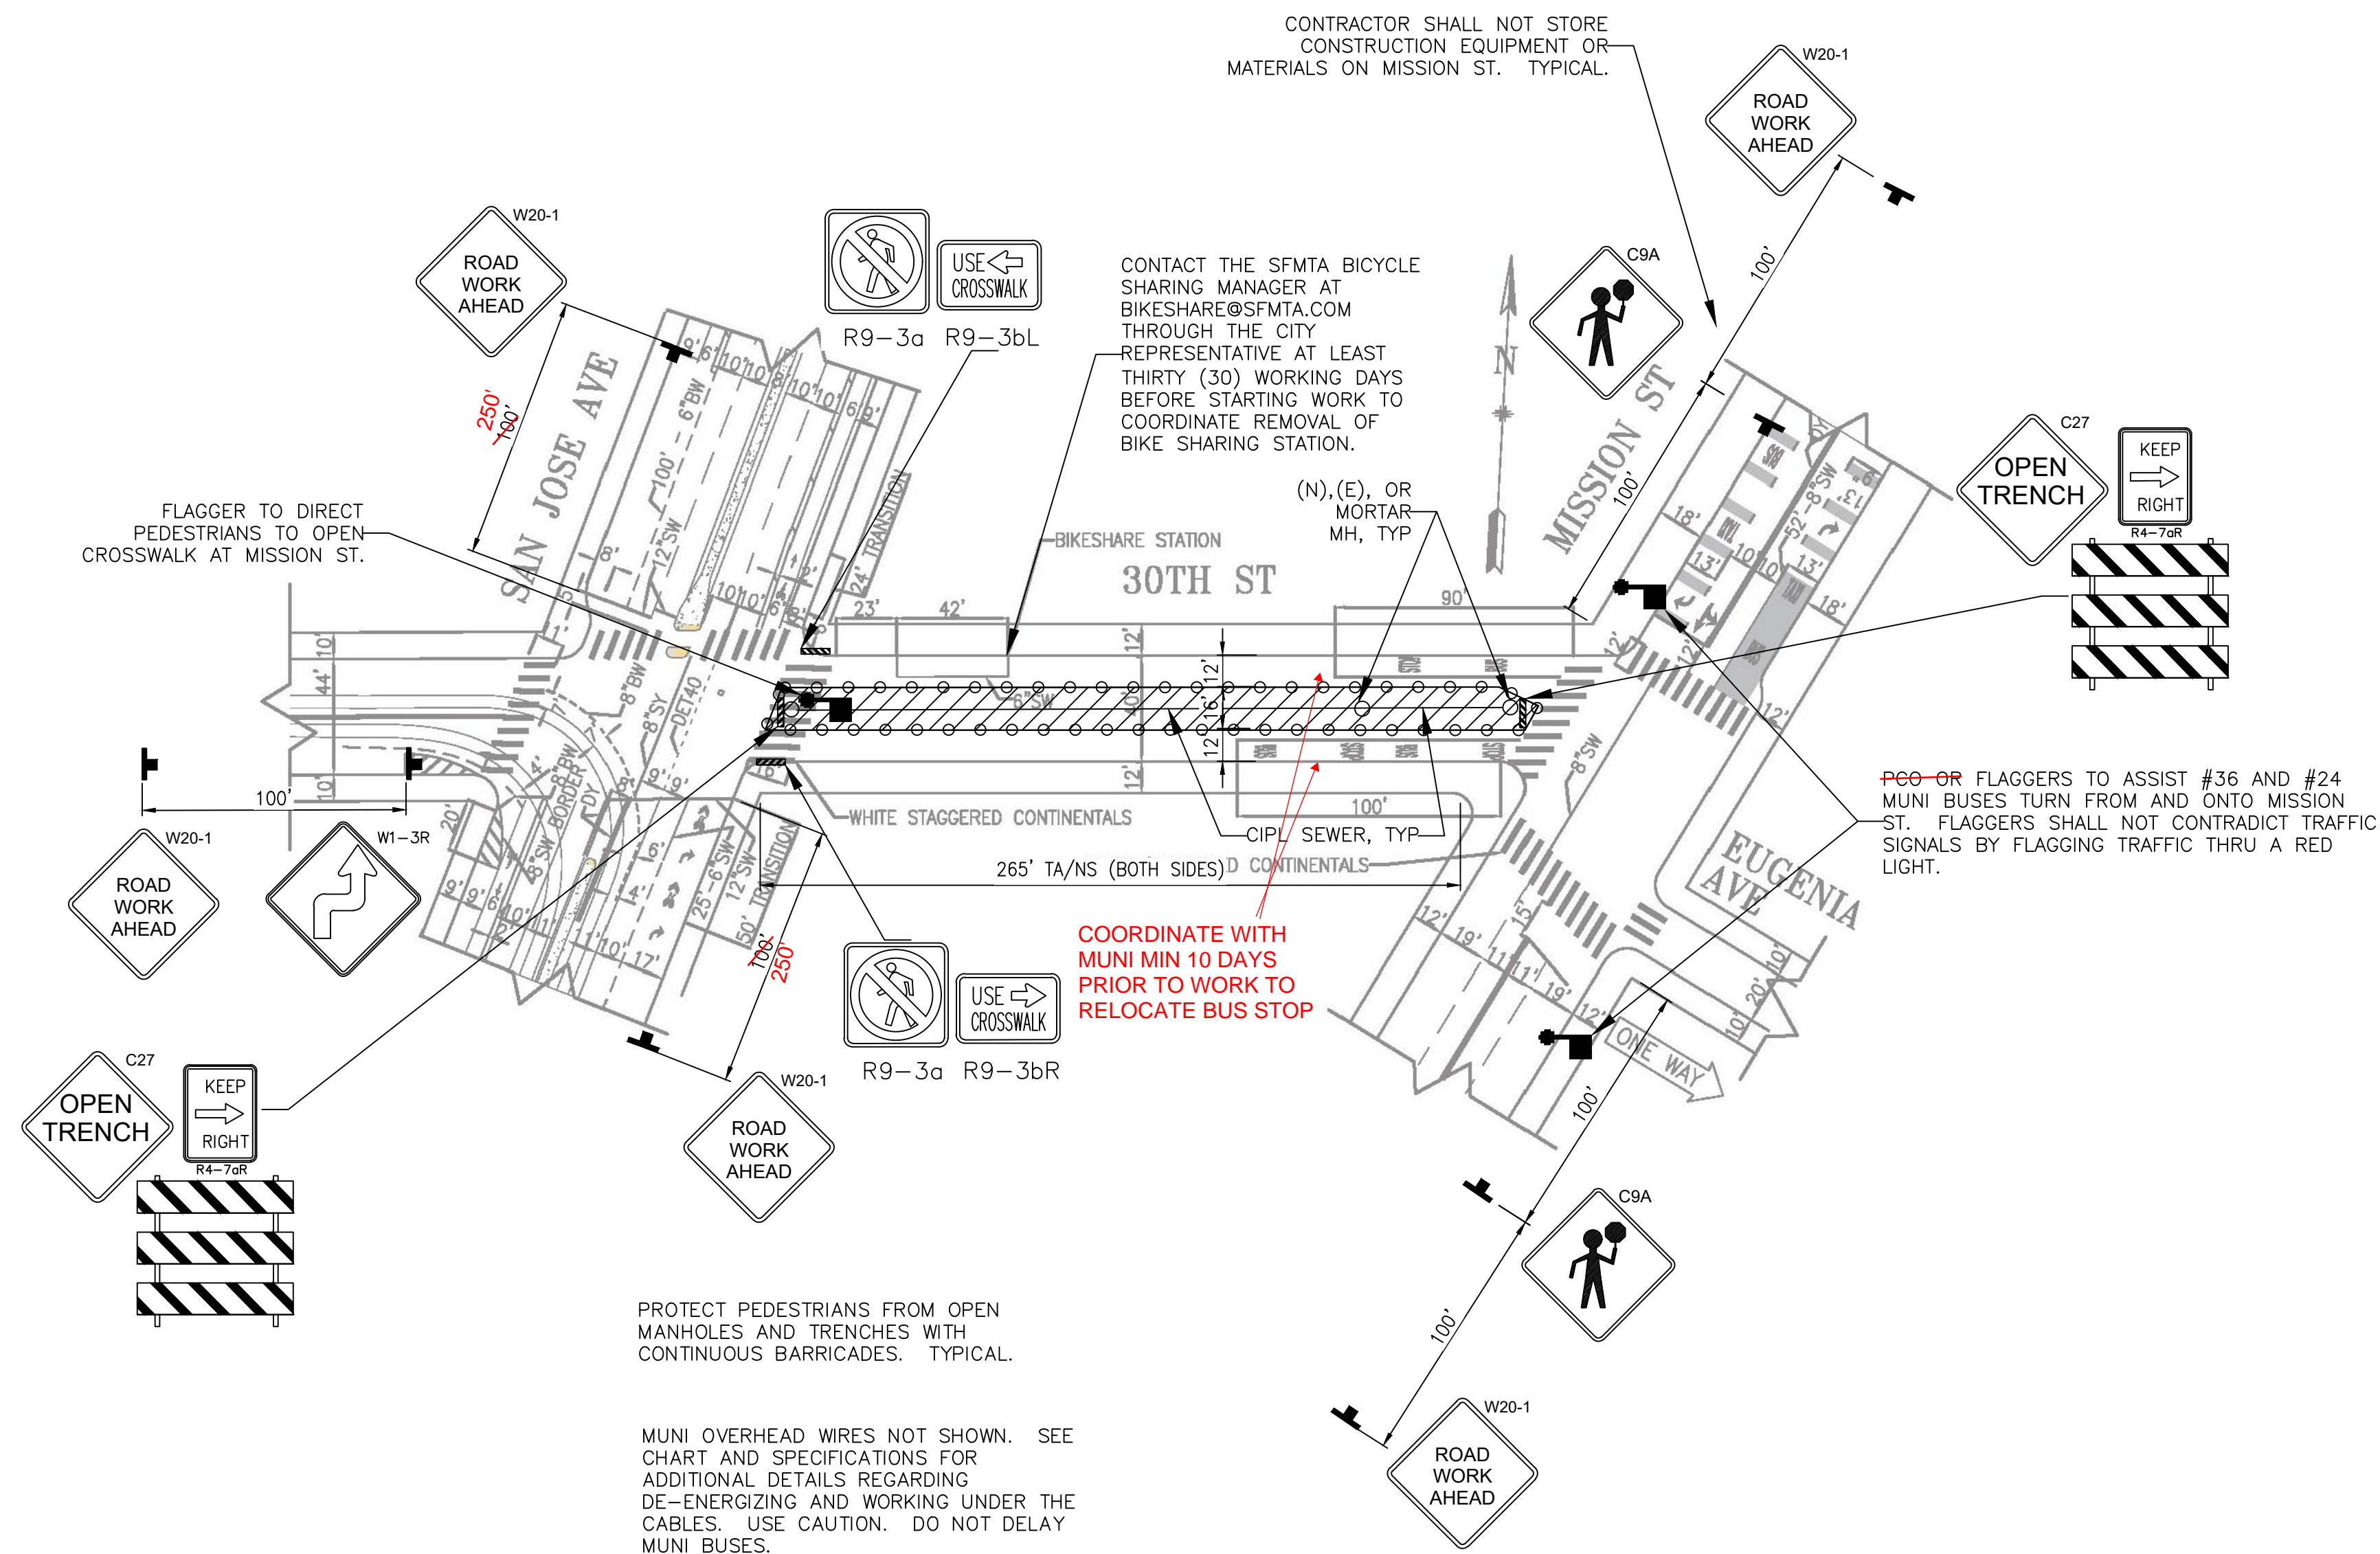

- ☒ NO EXCEPTIONS TAKEN
☒ MAKE CORRECTIONS NOTED
☒ REJECTED
☒ REVISE AND RESUBMIT
☒ SUBMIT SPECIFIC ITEM(S)
- Review is only for general conformance with the design concept of the project and general compliance with the requirements of the contract documents. Any action shown is subject to the requirements of the plans and specifications. Contractor's responsibilities include, but are not limited to actual dimensions shown, field confirmed and correlated at the job site; preferred fabrication processes and techniques of construction; coordination of the contractor's work with that of all other trades; and the satisfactory performance of the contractor's work.
- Sustainable Streets Division
San Francisco Transportation Agency
City and County of San Francisco
- S. Wong/S. Chan* Date *4/11/2022*

0 50 100 150
1" = 50' GRAPHIC SCALE

Revisions				
No.	Revisions	By	Date	Appr



BAY-CON INFRASTRUCTURE
PO BOX 1342
SAN MATEO CA 94401
(415) 580-1441 OFFICE
(415) 329-3240 FAX
INFO@BAY-CON.COM

y Plan

This document is the property of the engineer and is not to be used without engineer's written permission. Satellite imagery provided by Google Earth.

Engineer Of Record:
PHIL MIESZKOWSKI, PE



3/14/2022

DESIGN DOCUMENTS
TEMPORARY TRAFFIC CONTROL

ent
MICHAEL O'SHAUGHNESSY CONSTRUCTION, INC
8 RIVERTON DR
SAN FRANCISCO, CA 94132
(415) 726-3052
OFFICE@MOSCONSTRUCTION.ORG

AN FRANCISCO PUBLIC WORKS
9 S VAN NESS AVE, SUITE 1600
SAN FRANCISCO, CA 94103
(415) 228-2711
CONTRACTADMIN.STAFF@SFDPW.ORG

VARIOUS LOCATIONS NO. 52 PAVEMENT
RENOVATION AND SEWER REPLACEMENT
SAN FRANCISCO, CA
SOURCING ID NO. 0000003758

Sheet Title
TEMPORARY TRAFFIC CONTROL PLAN FOR
SEWER CIPL AND MANHOLE WORK ON 30TH
ST FROM SAN JOSE AVE TO MISSION ST

Cl Job 146

own By PM

Checked By PM

Issue Date 3/14/2022

TCP-014