


NON-WORKING HOURS

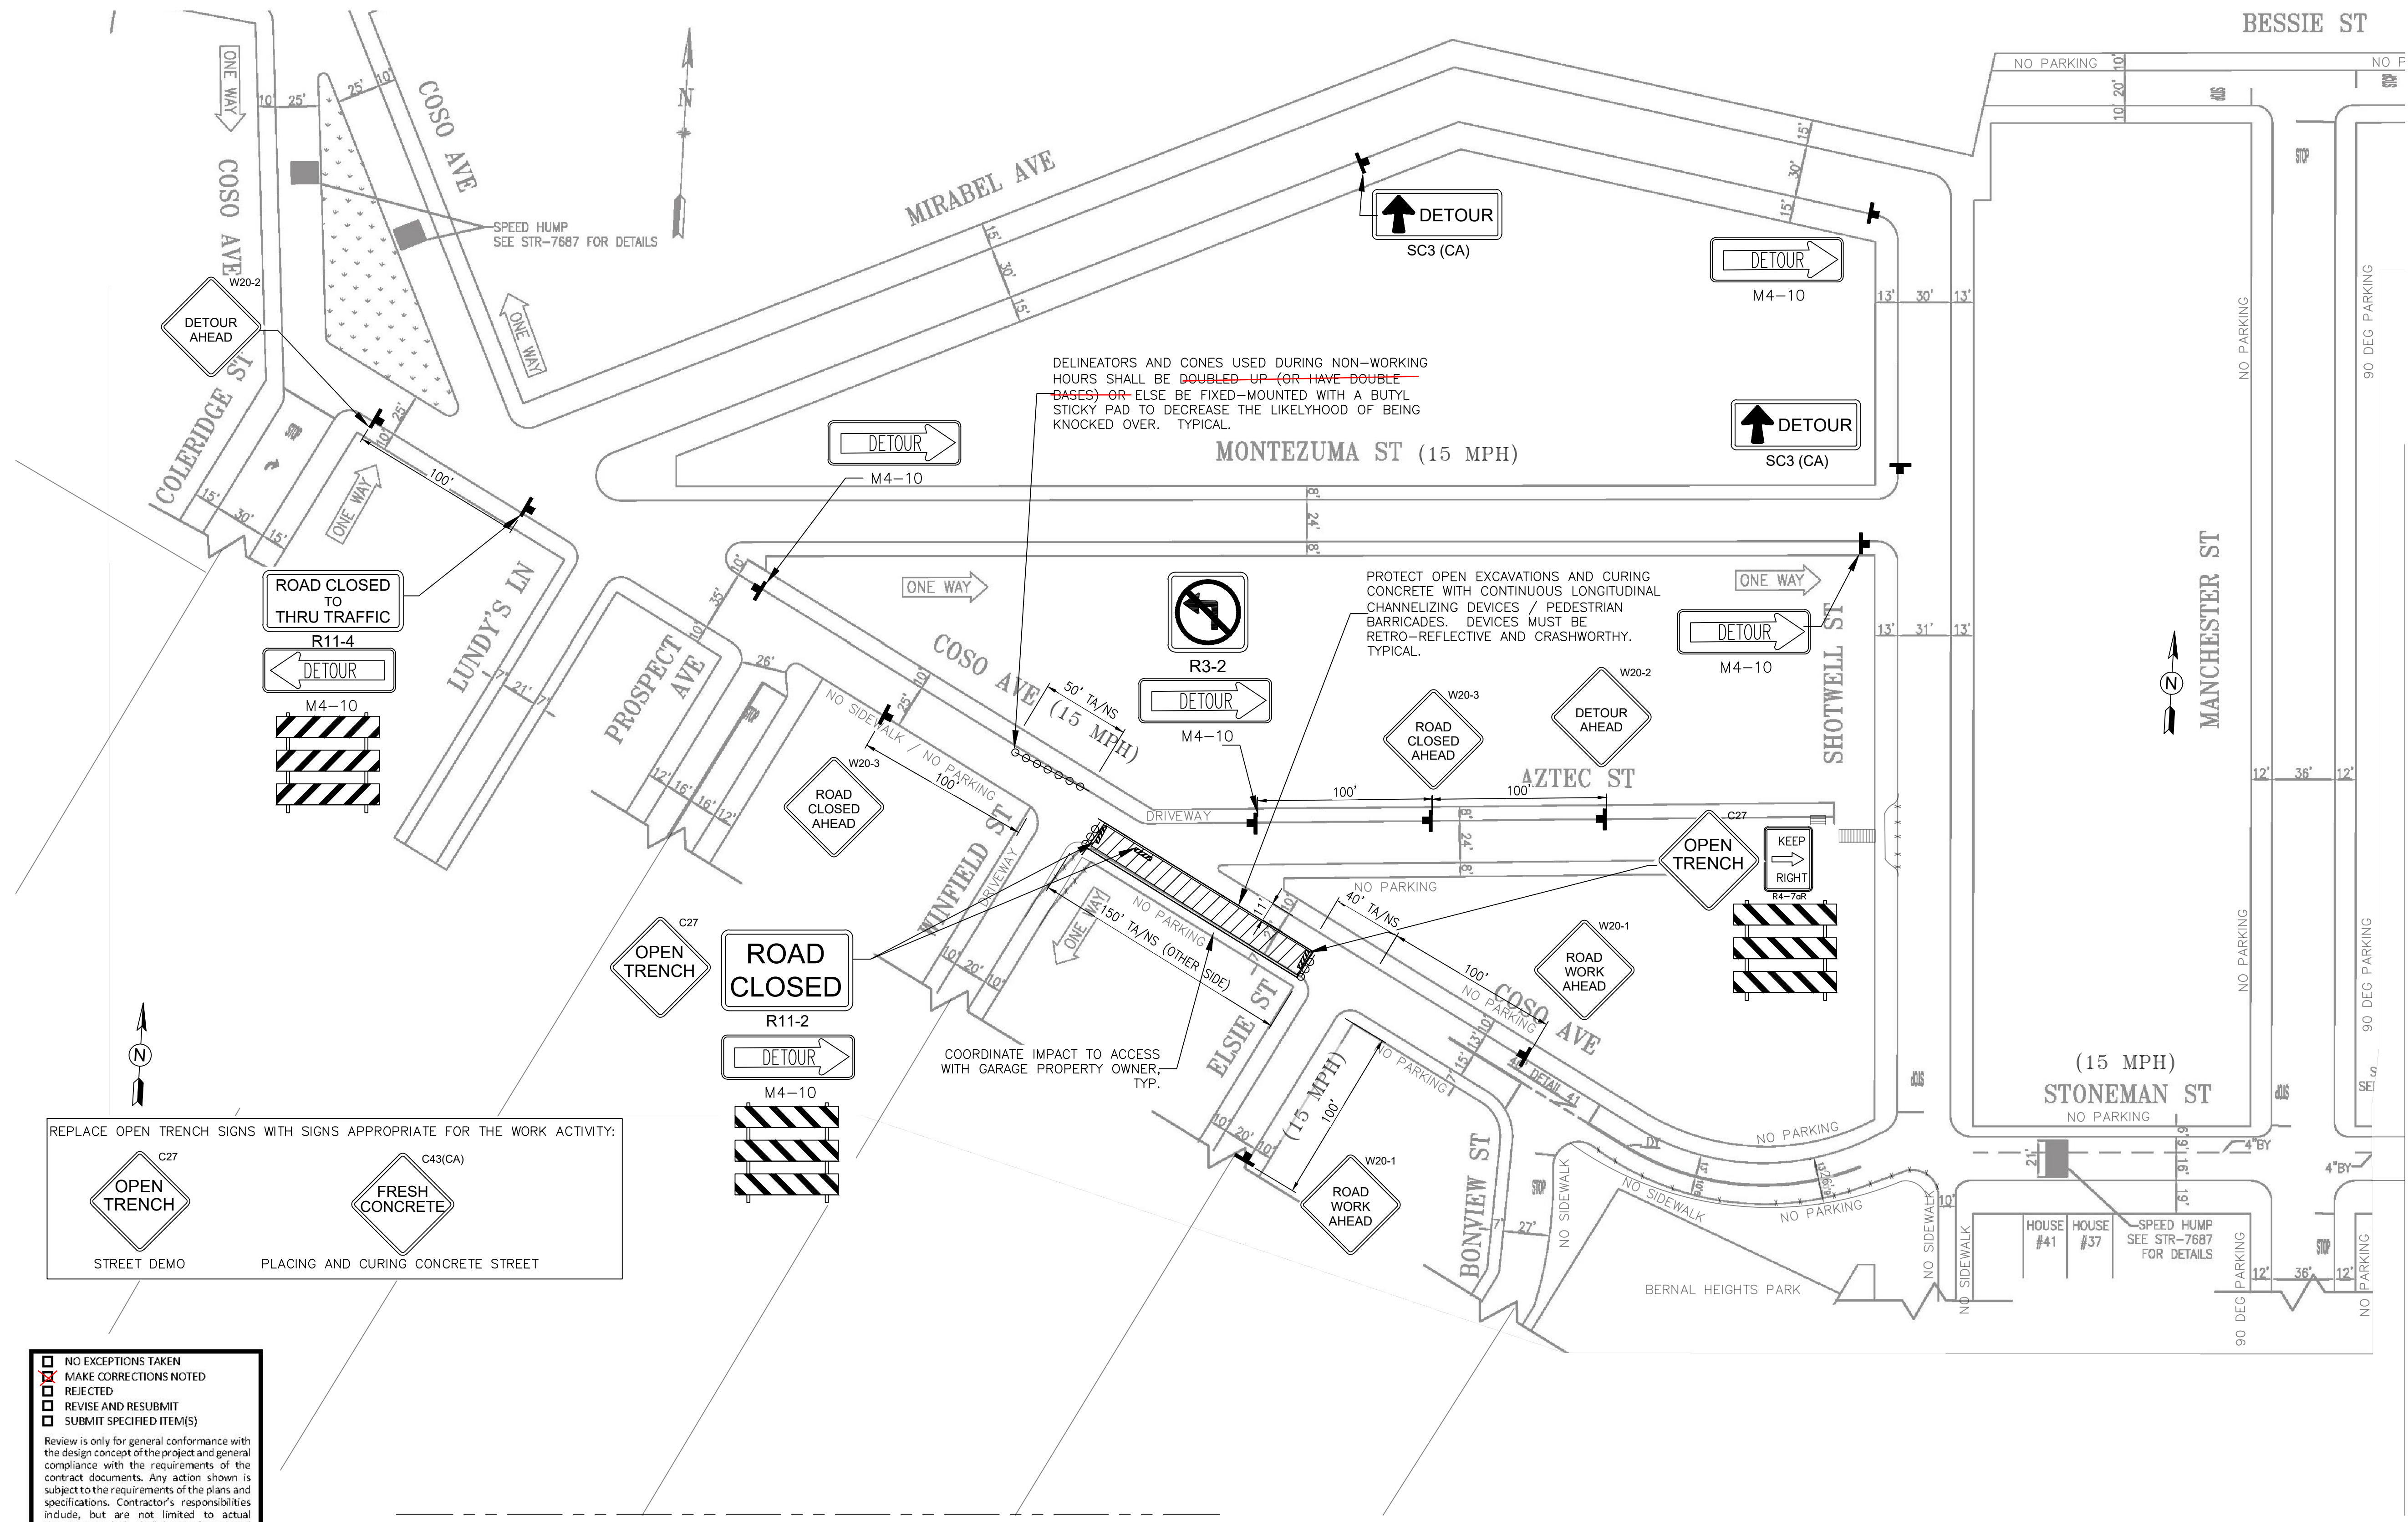

IF THIS SHEET IS NOT 24"x36" , IT IS
A REDUCED PRINT - SCALE ACCORDINGLY

0 50 100 150
1" = 50' GRAPHIC SCALE

Revisions				
No.	Revisions	By	Date	Appr.

BAY-CON
INFRASTRUCTURE

BAY-CON INFRASTRUCTURE
PO BOX 1342
SAN MATEO CA 94401
(415) 580-1441 OFFICE
(415) 329-3240 FAX
INFO@BAY-CON.COM

Key Plan

This document is the property of the engineer and is not to be used without engineer's written permission. Satellite imagery provided by Google Earth.

Engineer Of Record:
PHIL MIESZKOWSKI, PE

5/20/2022

DESIGN DOCUMENTS
TEMPORARY TRAFFIC CONTROL

Client
MICHAEL O'SHAUGHNESSY CONSTRUCTION, INC
48 RIVINGTON DR
SAN FRANCISCO, CA 94132
(415) 726-3052
OFFICE@MOSCONSTRUCTION.ORG

Owner
SAN FRANCISCO PUBLIC WORKS
49 S VAN NESS AVE, SUITE 1600
SAN FRANCISCO, CA 94103
(628) 271-3139
CONTRACTADMIN.STAFF@SFPD.PW.ORG

Project
VARIOUS LOCATIONS NO. 52 PAVEMENT
RENOVATION AND SEWER REPLACEMENT
SAN FRANCISCO, CA
SOURCING ID NO. 0000003758

Sheet Title
TCP FOR CONCRETE STREET
RECONSTRUCTION ON COSO AVE FROM
WINFIELD ST TO ELSIE ST - NON-WORKING
HOURS - SHEET 12 OF 46

BCI Job 146	Sheet TCP-054
Drwn By PM	
Chckd By PM	
Issue Date 05/20/2022	

54, 5/20/2022 1:37:03 PM

☐ NO EXCEPTIONS TAKEN
☒ MAKE CORRECTIONS NOTED
☐ REJECTED
☐ REVISE AND RESUBMIT
☐ SUBMIT SPECIFIED ITEM(S)

Review is only for general conformance with the design concept of the project and general compliance with the requirements of the contract documents. Any action shown is subject to the requirements of the plans and specifications. Contractor's responsibilities include, but are not limited to actual dimensions which shall be confirmed and correlated at the job site; preferred fabrication processes and techniques of construction; coordination of the contractor's work with that of all other trades; and the satisfactory performance of the contractor's work.

Sustainable Streets Division
San Francisco Municipal Transportation Agency
City and County of San Francisco

By: *G. Lopez* Date: 6/23/22