

Traffic Lane Requirements Number and Width of Lanes					
STREET	TIME	NORTHBOUND	SOUTHBOUND	EASTBOUND	WESTBOUND
GRINDING, PAVING, CONCRETE STREET, & BASE REPAIR WORK					
<u>COSO AVENUE</u>					
Precita Ave to Mirabel Ave ☉	8AM – 4PM (M-F) Concrete Curing At Other Times	Closed☉ 1@11' Full Rdwy	Closed☉ Closed☉ Full Rdwy	- - -	- - -
<u>Cross Streets for Coso Ave</u>					
Precita Ave	At All Times	-	-	Full Rdwy	Full Rdwy
Mirabel Ave ☉	8AM – 4PM (M-F) Concrete Curing At Other Times	- - -	- - -	Closed☉ 1@11' Full Rdwy	Closed☉ Closed☉ Full Rdwy


© The Contractor may close this road to through traffic only during work hours. "Road Closed" signs shall be removed or covered during non-working hours. The Contractor shall set up detour signs in accordance with the approved traffic detour plans as deemed necessary. Local access must be maintained at all times.

☐ NO EXCEPTIONS TAKEN
☒ MAKE CORRECTIONS NOTED
☐ REJECTED
☐ REVISE AND RESUBMIT
☐ SUBMIT SPECIFIED ITEM(S)

Review is only for general conformance with the design concept of the project and general compliance with the requirements of the contract documents. Any action shown is subject to the requirements of the plans and specifications. Contractor's responsibilities include, but are not limited to actual dimensions which shall be confirmed and correlated at the job site; preferred fabrication processes and techniques of construction; coordination of the contractor's work with that of all other trades; and the satisfactory performance of the contractor's work.

Sustainable Streets Division
San Francisco Municipal Transportation Agency
City and County of San Francisco

By: Carol Kwei Date: 6/9/22

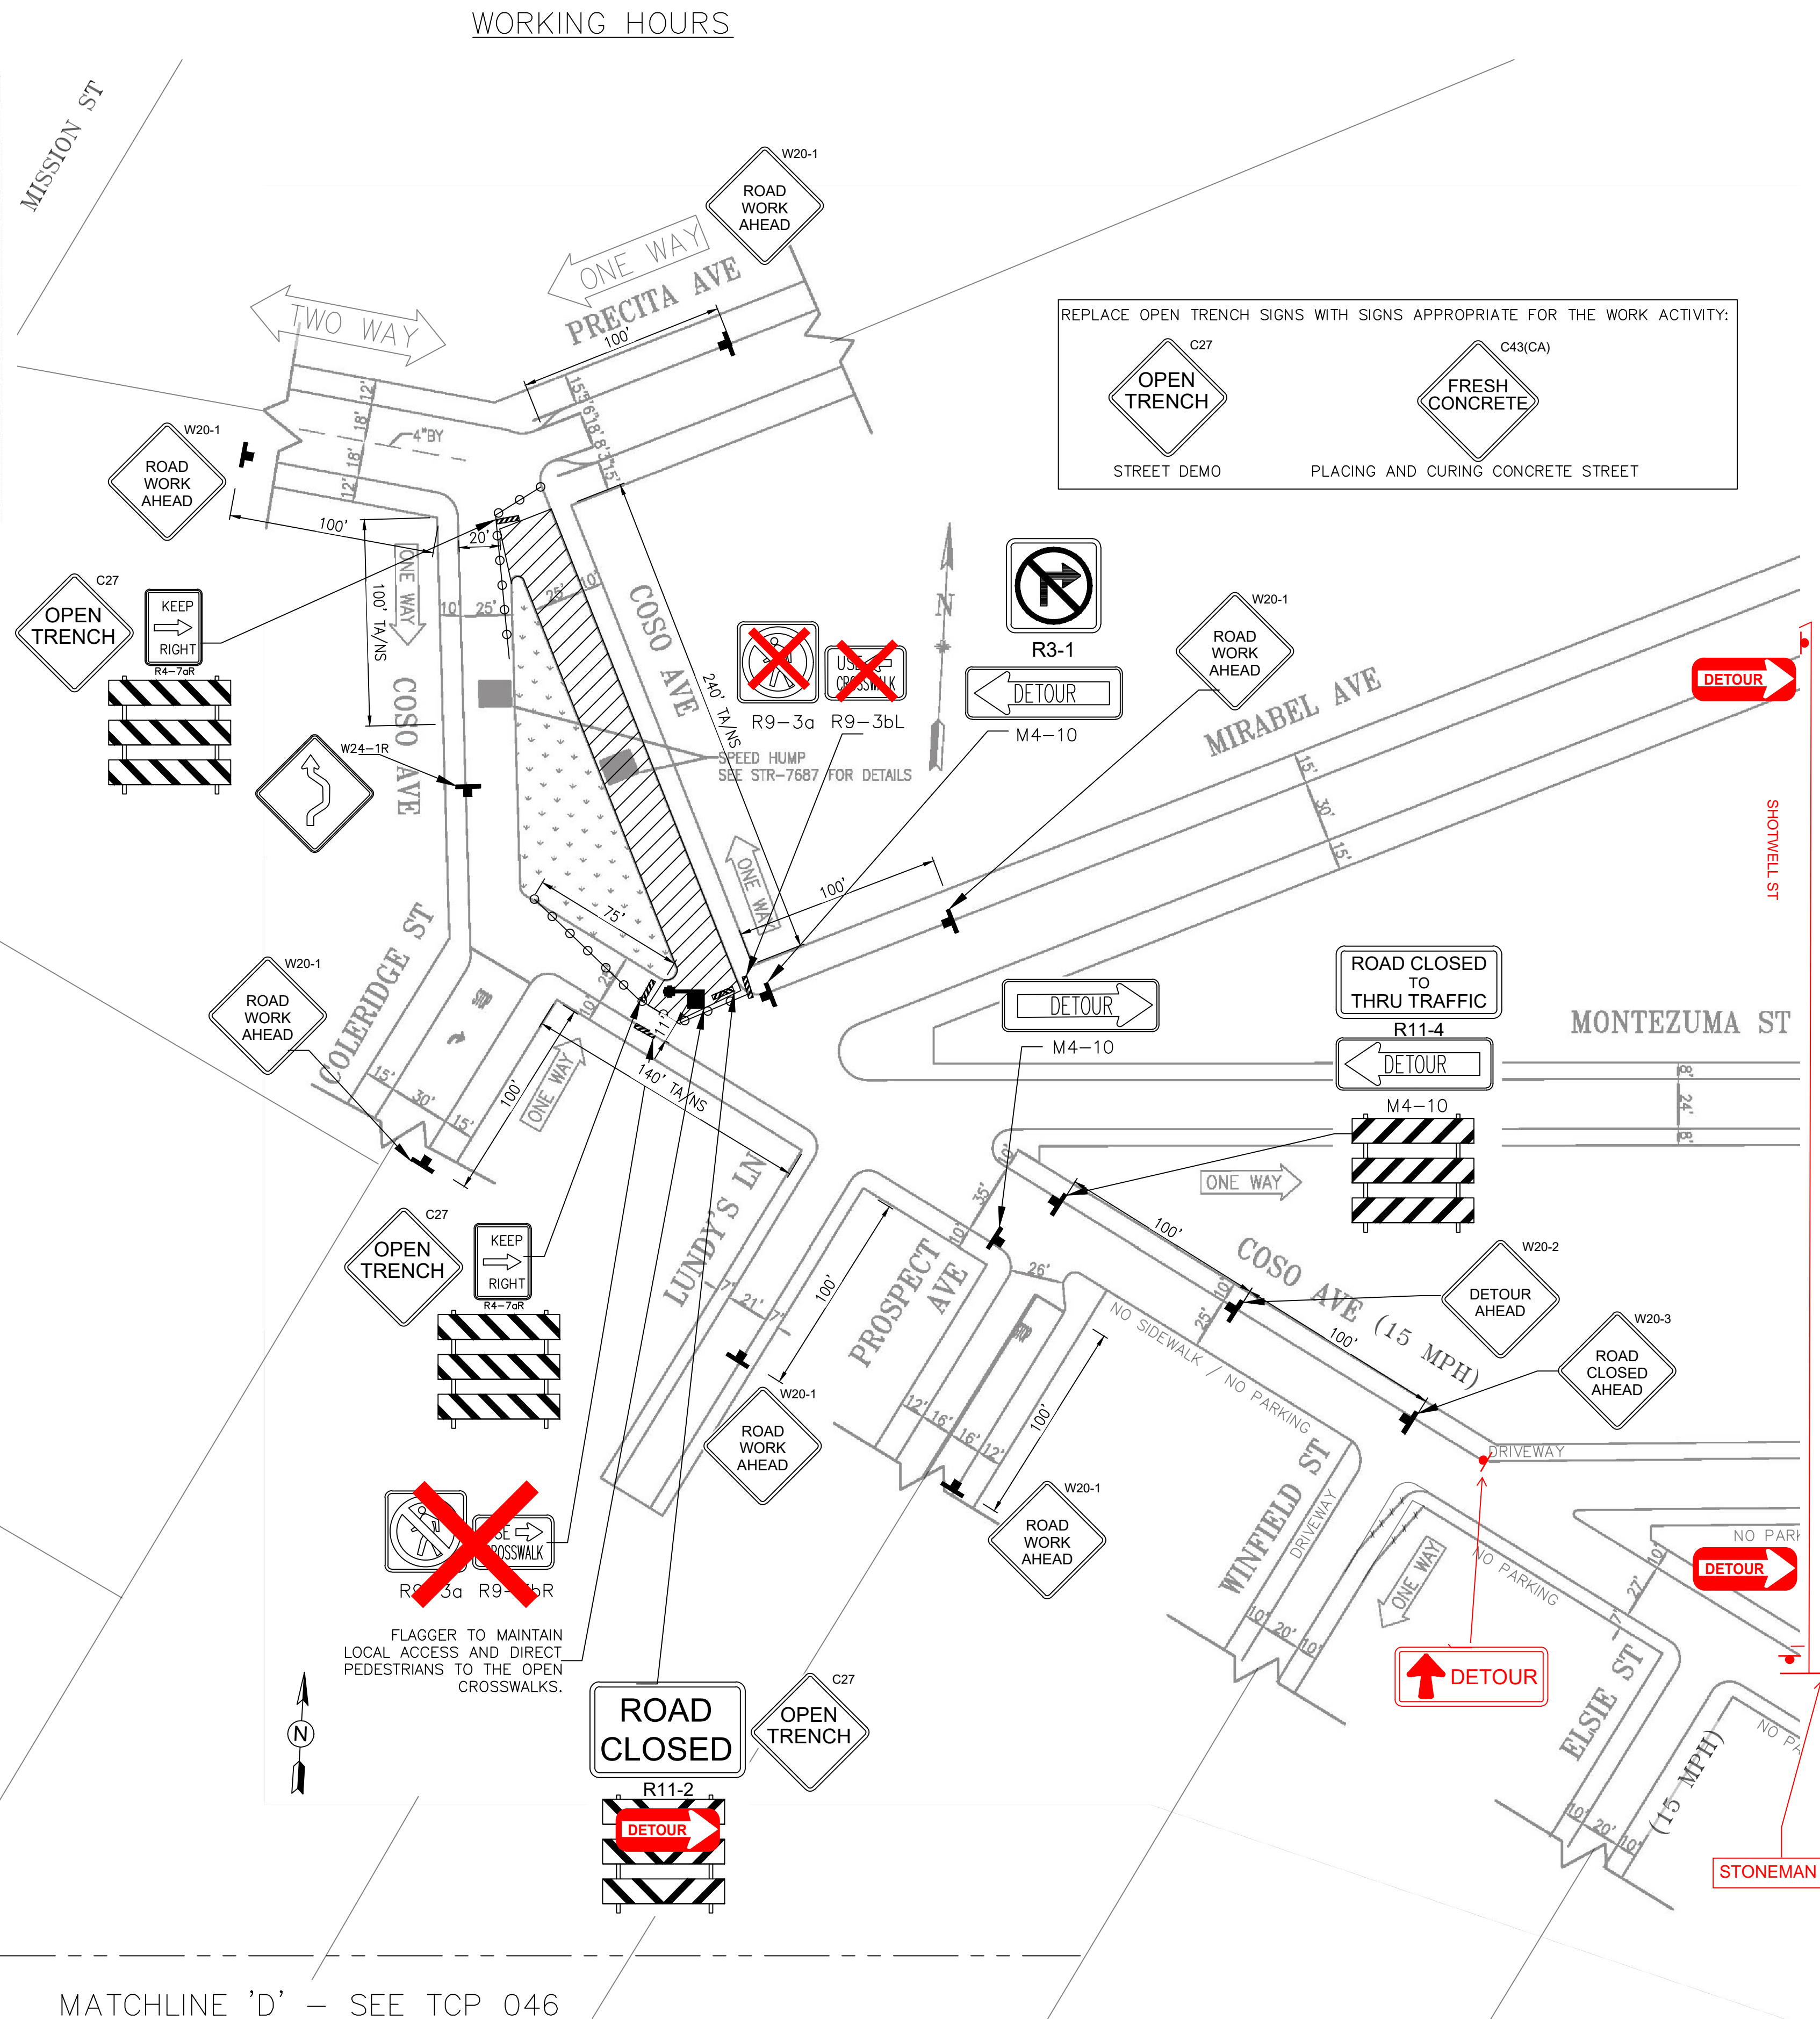

IF THIS SHEET IS NOT 24"x36", IT IS
A REDUCED PRINT - SCALE ACCORDINGLY

0 50 100 150
1" = 50' GRAPHIC SCALE

[illegible]

BAY-CON INFRASTRUCTURE
PO BOX 1342
SAN MATEO CA 94401
(415) 580-1441 OFFICE
(415) 329-3240 FAX
INFO@BAY-CON.COM

Key Plan

This document is the property of the engineer and is not to be used without engineer's written permission. Satellite imagery provided by Google Earth.

Engineer Of Record:
PHIL MIESZKOWSKI, PE

DESIGN DOCUMENTS
TEMPORARY TRAFFIC CONTROL

Client
MICHAEL O'SHAUGHNESSY CONSTRUCTION, INC
48 RIVERTON DR
SAN FRANCISCO, CA 94132
(415) 726-3052
OFFICE@MOSCONSTRUCTION.ORG

Owner
SAN FRANCISCO PUBLIC WORKS
49 S VAN NESS AVE, SUITE 1600
SAN FRANCISCO, CA 94103
(628) 271-3139
~~CONTRACTADMIN.STAFF@SFPD.W.ORG~~

Project
VARIOUS LOCATIONS NO. 52 PAVEMENT
RENOVATION AND SEWER REPLACEMENT
SAN FRANCISCO, CA
SOURCING ID NO. 0000003758

Sheet Title
TCP FOR CONCRETE STREET
RECONSTRUCTION ON COSO AVE FROM
PRECITA AVE TO MIRABEL AVE - SHEET 3
OF 46

BCI Job	146	
Drwn By	PM	
Chckd By	PM	Sheet
Issue Date	05/20/2022	TCP-045