


IF THIS SHEET IS NOT 24"x36" , IT IS
A REDUCED PRINT - SCALE ACCORDINGLY

0 50 100 150
1" = 50' GRAPHIC SCALE

Revisions				
No.	Revisions	By	Date	Appr.

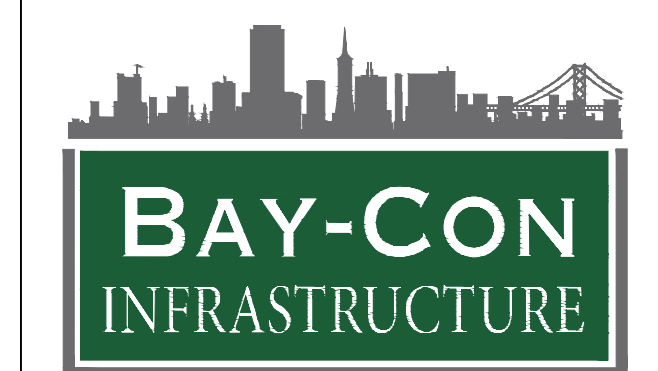

BAY-CON INFRASTRUCTURE
PO BOX 1342
SAN MATEO CA 94401
(415) 580-1441 OFFICE
(415) 329-3240 FAX
INFO@BAY-CON.COM

Key Plan

This document is the property of the engineer and is not to be used without engineer's written permission. Satellite imagery provided by Google Earth.

Engineer Of Record:
PHIL MIESZKOWSKI, PE



DESIGN DOCUMENTS
TEMPORARY TRAFFIC CONTROL

Client
MICHAEL O'SHAUGHNESSY CONSTRUCTION, INC
48 RIVERTON DR
SAN FRANCISCO, CA 94132
(415) 726-3052
OFFICE@MOSCONSTRUCTION.ORG
Owner
SAN FRANCISCO PUBLIC WORKS
49 S VAN NESS AVE, SUITE 1600
SAN FRANCISCO, CA 94103
(628) 271-3139
CONTRACTADMIN.STAFF@SFPD.PW.ORG
Project
VARIOUS LOCATIONS NO. 52 PAVEMENT
RENOVATION AND SEWER REPLACEMENT
SAN FRANCISCO, CA
SOURCING ID NO. 0000003758

Sheet Title
TEMPORARY TRAFFIC CONTROL PLAN FOR
SEWER CIPL WORK ON COSO AVE AT
WINFIELD ST AND AZTEC ST - SHEET 1 OF 2

BCI Job 146
Drwn By PM
Chckd By PM
Issue Date 3/7/2022

Sheet
TCP-009

☒ NO EXCEPTIONS TAKEN
☐ MAKE CORRECTIONS NOTED
☐ REJECTED
☐ REVISE AND RESUBMIT
☐ SUBMIT SPECIFIED ITEM(S)

Review is only for general conformance with the design concept of the project and general compliance with the requirements of the contract documents. Any action shown is subject to the requirements of the plans and specifications. Contractor's responsibilities include, but are not limited to actual dimensions which shall be confirmed and correlated at the job site; preferred fabrication processes and techniques of construction; coordination of the contractor's work with that of all other trades; and the satisfactory performance of the contractor's work.

Sustainable Streets Division
San Francisco Municipal Transportation Agency
City and County of San Francisco
By: [Signature] Date: 4/2/22

- NOTES:**
- A SPECIAL TRAFFIC PERMIT MAY BE REQUIRED FOR THIS WORK. IT IS NOT POSSIBLE TO PROVIDE AN 11' LANE ON WINFIELD ST. NOTE THAT THE CURB LINE FOR WINFIELD ST SHOWN ON DRAWING T-1 IS NOT ACCURATE.

Traffic Lane Requirements Number and Width of Lanes					
STREET	TIME	NORTHBOUND	SOUTHBOUND	EASTBOUND	WESTBOUND
SEWER LINING WORK					
COSO AVENUE					
Winfield St to Aztec St ↓	8AM – 4PM (M-F) At Other Times	1@11' Reversible↑ Full Rdwy	-	-	-
Precita Ave intersection	8AM – 4PM (M-F) At Other Times	1@11' Full Rdwy	1@11' Full Rdwy	-	-
Cross Streets for Coso Ave					
STREET	TIME	NORTHBOUND	SOUTHBOUND	EASTBOUND	WESTBOUND
Winfield St	8AM – 4PM (M-F) At Other Times	-	-	-	1@11' Full Rdwy
Aztec St ↓	8AM – 4PM (M-F) At Other Times	-	-	1@11' Reversible↑ Full Rdwy	-