
Traffic Lane Requirements Number and Width of Lanes

STREET	TIME	NORTHBOUND	SOUTHBOUND	EASTBOUND	WESTBOUND
SEWER LIN	NING WORK		Ī		
COSO AVENI	JE_				
Precita Ave intersection	8AM – 4PM (M-F) At Other Times	1@11' Full Rdwy	1@11' Full Rdwy	4 10	-
Cross Streets	for Coso Ave				
Precita Ave	At All Times	<u> </u>	r <u>u</u>	Full Rdwy	Full Rdwy

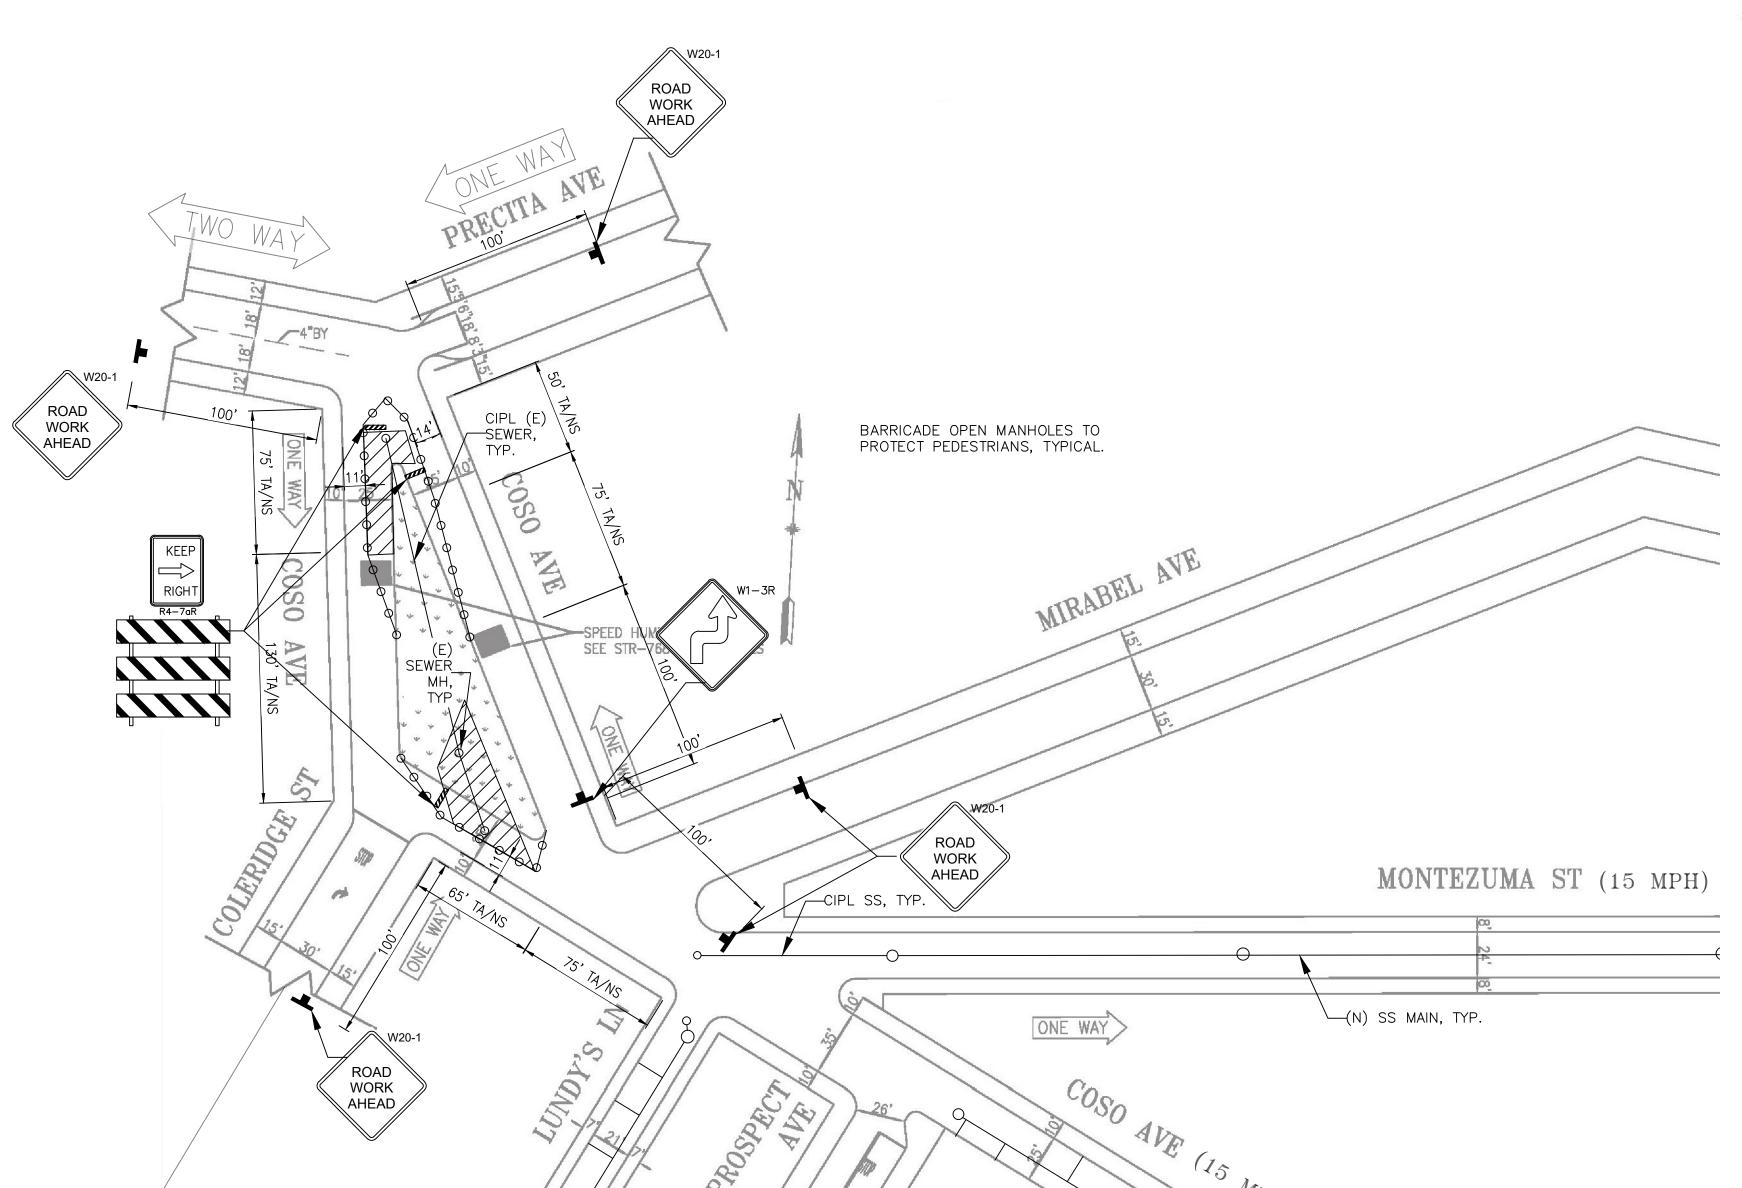

☑ NO EXCEPTIONS TAKEN ■ MAKE CORRECTIONS NOTED □ REJECTED ■ REVISE AND RESUBMIT ■ SUBMIT SPECIFIED ITEM(S)

Review is only for general conformance with the design concept of the project and general compliance with the requirements of the contract documents. Any action shown is subject to the requirements of the plans and specifications. Contractor's responsibilities include, but are not limited to actual dimensions which shall be confirmed and correlated at the job site; preferred fabrication processes and techniques of construction; coordination of the contractor's work with that of all other trades; and the satisfactory performance of the contractor's work.

Sustainable Streets Division San Francisco Municipal Transportation Agency City and County of San Francisco

IF THIS SHEET IS NOT 24"x36" , IT IS A REDUCED PRINT - SCALE ACCORDINGLY

GRAPHIC SCALE

No. Revisions



BAY-CON INFRASTRUCTURE PO BOX 1342 SAN MATEO CA 94401 (415) 580-1441 OFFICE (415) 329-3240 FAX ÌNFO@BAY-CON.COM

Key Plan

This document is the property of the engineer and is not to be used without engineer's written permission. Satellite imagery provided by Google Earth.

Engineer Of Record:

PHIL MIESZKOWSKI, PE



DESIGN DOCUMENTS TEMPORARY TRAFFIC CONTROL

MICHAEL O'SHAUGHNESSY CONSTRUCTION, INC 48 RIVERTON DR SAN FRANCISCO, CA 94132 (415) 726-3052 OFFICE@MOSCONSTRUCTION.ORG

SAN FRANCISCO PUBLIC WORKS
49 S VAN NESS AVE, SUITE 1600
SAN FRANCISCO, CA 94103
(628) 271-3139
CONTRACTADMIN.STAFF@SFDPW.ORG

VARIOUS LOCATIONS NO. 52 PAVEMENT RENOVATION AND SEWER REPLACEMENT SAN FRANCISCO, CA SOURCING ID NO. 0000003758

Sheet Title
TEMPORARY TRAFFIC CONTROL PLAN FOR
SEWER CIPL AND MANHOLE MORTARING ON
COSO AVE FROM PRECITA AVE TO MIRABEL

BCI Job 146 Drwn By PM

Chckd By PM

Issue Date 3/14/2022