

| STREET | TIME | NORTHBOUND | SOUTHBOUND | EASTBOUND | WESTBOUND |
|-------------------------------------|-----------------------------------|----------------------|----------------------|--------------------|-----------|
| SEWER MAIN WORK | | | | | |
| | | | | | |
| <u>ANDOVER STREET</u> | | | | | |
| end to Benton Ave @ | 8AM – 4PM (M-F) At Other Times | Closed@ Full Rdwy | Closed@ Full Rdwy | - - | - - |
| <u>Cross Streets for Andover St</u> | | | | | |
| Benton Ave | 8AM – 4PM (M-F) At Other Times | - - | - - | 1@12' Full Rdwy | - - |
| | | | | | |


| STREET | TIME | NORTHBOUND | SOUTHBOUND | EASTBOUND | WESTBOUND |
|-------------------------------------|-----------------------------------|----------------------|----------------------|--------------------|-----------|
| SEWER MAIN WORK | | | | | |
| | | | | | |
| <u>ANDOVER STREET</u> | | | | | |
| end to Benton Ave @ | 8AM – 4PM (M-F) At Other Times | Closed@ Full Rdwy | Closed@ Full Rdwy | - - | - - |
| <u>Cross Streets for Andover St</u> | | | | | |
| Benton Ave | 8AM – 4PM (M-F) At Other Times | - - | - - | 1@12' Full Rdwy | - - |
| | | | | | |

☐ NO EXCEPTIONS TAKEN
☒ MAKE CORRECTIONS NOTED
☐ REJECTED
☐ REVISE AND RESUBMIT
☐ SUBMIT SPECIFIED ITEM(S)

Review is only for general conformance with the design concept of the project and general compliance with the requirements of the contract documents. Any action shown is subject to the requirements of the plans and specifications. Contractor's responsibilities include, but are not limited to actual dimensions which shall be confirmed and correlated with the contractor's preferred fabrication processes and techniques of construction; coordination of the contractor's work with that of all other trades; and the satisfactory performance of the contractor's work.

Sustainable Streets Division
 San Francisco Municipal Transportation Agency
 City and County of San Francisco

BY S. Wong / S. Chan Date 4/11/2022

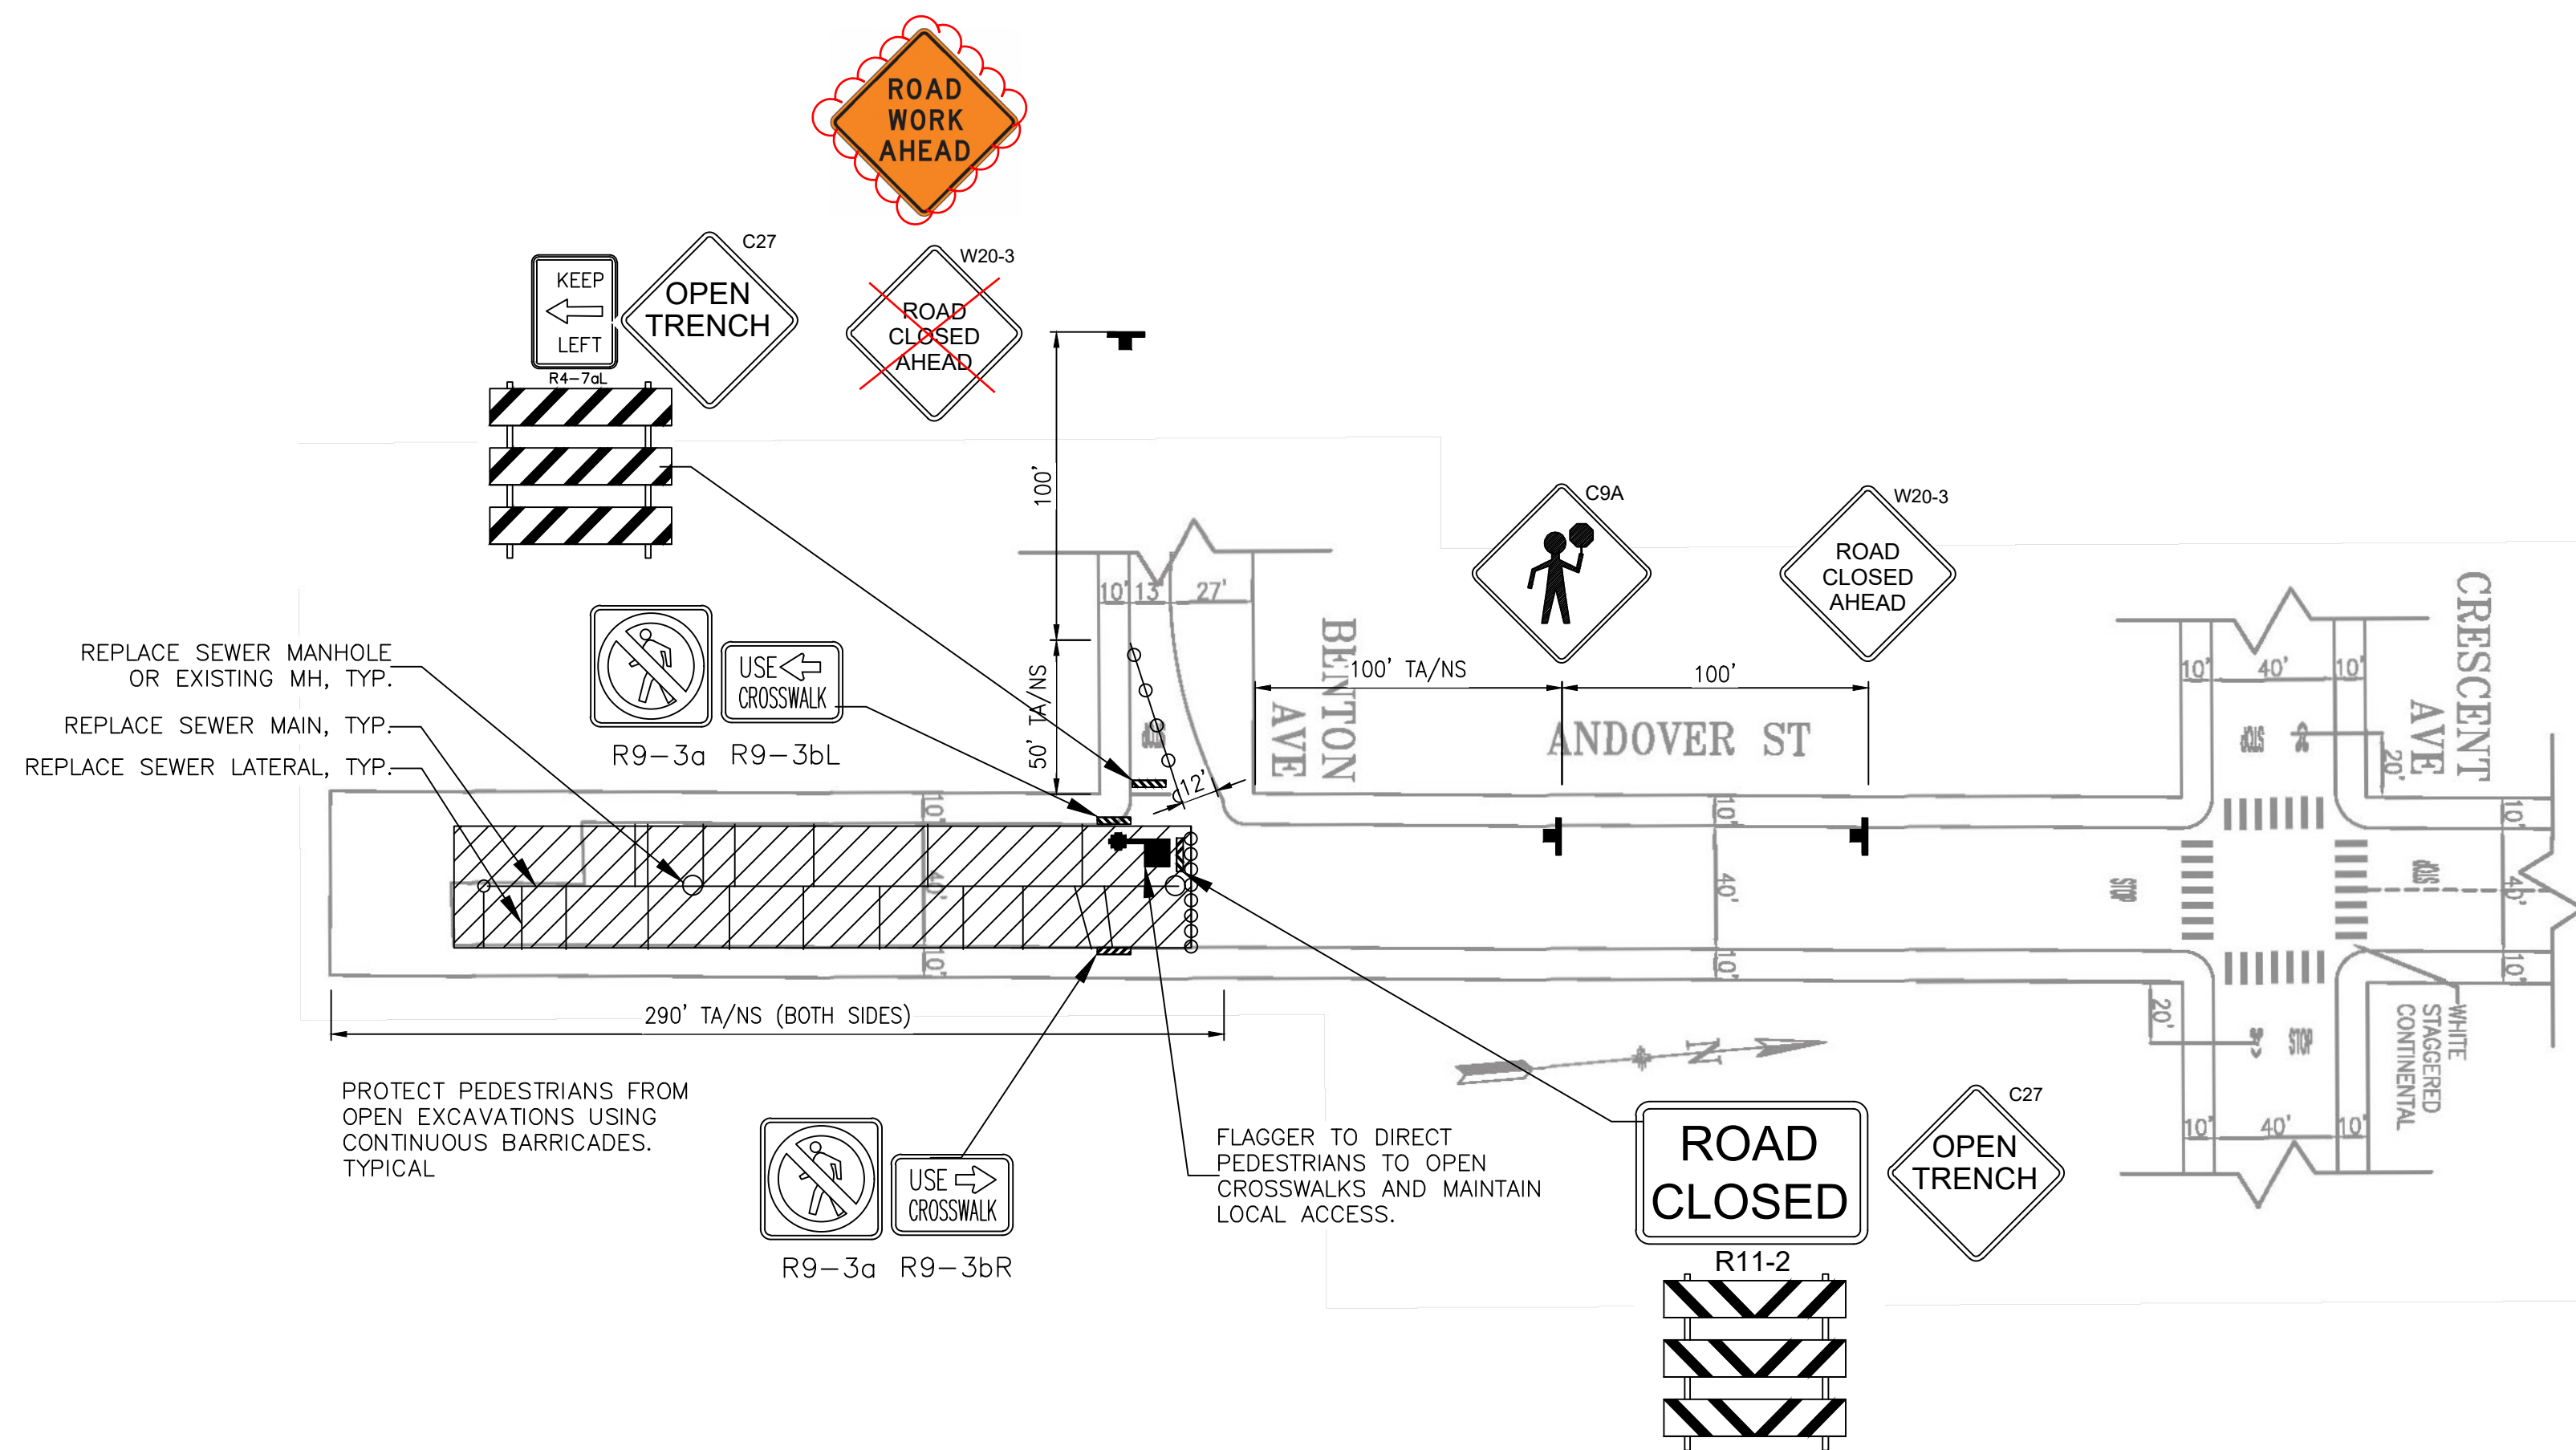

| Revisions | | | | |
|-----------|-----------|----|------|------|
| No. | Revisions | By | Date | Appr |
| | | | | |
| | | | | |
BAY-CON INFRASTRUCTURE
PO BOX 1342
SAN MATEO CA 94401
(415) 580-1441 OFFICE
(415) 329-3240 FAX
INFO@BAY-CON.COM

Key Plan

This document is the property of the engineer and is not to be used without engineer's written permission. Satellite imagery provided by Google Earth.

Engineer Of Record:
PHIL MIESZKOWSKI, PE



DESIGN DOCUMENTS
TEMPORARY TRAFFIC CONTROL

Client
MICHAEL O'SHAUGHNESSY CONSTRUCTION, INC
48 RIVERTON DR
SAN FRANCISCO, CA 94132
(415) 726-3052
OFFICE@MOSCONSTRUCTION.ORG

Owner
SAN FRANCISCO PUBLIC WORKS
49 S VAN NESS AVE, SUITE 1600
SAN FRANCISCO, CA 94103
(628) 271-3139
CONTRACTADMIN.STAFF@SFPDPW.ORG

Project
VARIOUS LOCATIONS NO. 52 PAVEMENT
RENOVATION AND SEWER REPLACEMENT
SAN FRANCISCO, CA
SOURCING ID NO. 0000003758

Sheet Title
TEMPORARY TRAFFIC CONTROL PLAN FOR
SEWER MAIN AND MANHOLE CONSTRUCTION
ON ANDOVER ST FROM BENTON AVE TO END

BCI Job 146

Drwn By PM

Chckd By PM

Issue Date 3/14/2022

Sheet

TCP-017