

Traffic Lane Requirements
Number and Width of Lanes

STREET	TIME	NORTHBOUND	SOUTHBOUND	EASTBOUND	WESTBOUND
GRINDING, PAVING, CONCRETE STREET, & BASE REPAIR WORK					
ANDOVER STREET					
end to Crescent Ave	8AM – 4PM (M-F) At Other Times	1@11' Full Rdwy	1@11' Full Rdwy	- -	- -
Cross Streets for Andover St					
Benton Ave	8AM – 4PM (M-F) At Other Times	- -	- -	1@12' Full Rdwy	- -
Crescent Ave β *(MC)	At All Times	-	-	Full Rdwy	Full Rdwy

* The Contractor shall not prevent or delay the operation of mass transit vehicles at any time. TC = Trolley Coach, MC = Motor Coach, MM = SFMTA Metro. See Subsection 3.3 MASS TRANSIT VEHICLES for more information.

β The Contractor shall perform the appropriate measures to ensure the safety of bicyclists on ALL streets on which there is construction. Contractors shall pay special attention to streets that are on the Bicycle Route Network. See Blue Book Section 9: Bicycle Routes or on the internet at:

<https://www.sfmta.com/maps/san-francisco-bike-network-map>

The Contractor shall install "Bicyclists Allowed Use of Full Lane" signs, or other approved equal, on streets with bicycle lanes during construction.

☐ NO EXCEPTIONS TAKEN

☒ MAKE CORRECTIONS NOTED

☐ REJECTED

☐ REVISE AND RESUBMIT


☐ SUBMIT SPECIFIED ITEM(S)

Review is only for general conformance with the design concept of the project and general compliance with the requirements of the contract documents. Any action shown is subject to the requirements of the plans and specifications. Contractor's responsibilities include, but are not limited to, actual dimensions which shall be confirmed and correlated at the job site; preferred fabrication processes and techniques of construction; coordination of the contractor's work with that of all other trades; and the satisfactory performance of the contractor's work.

Sustainable Streets Division
San Francisco Municipal Transportation Agency
City and County of San Francisco

By: *G. P. H.* Date: 7/25/22

WORKING AND NON-WORKING HOURS

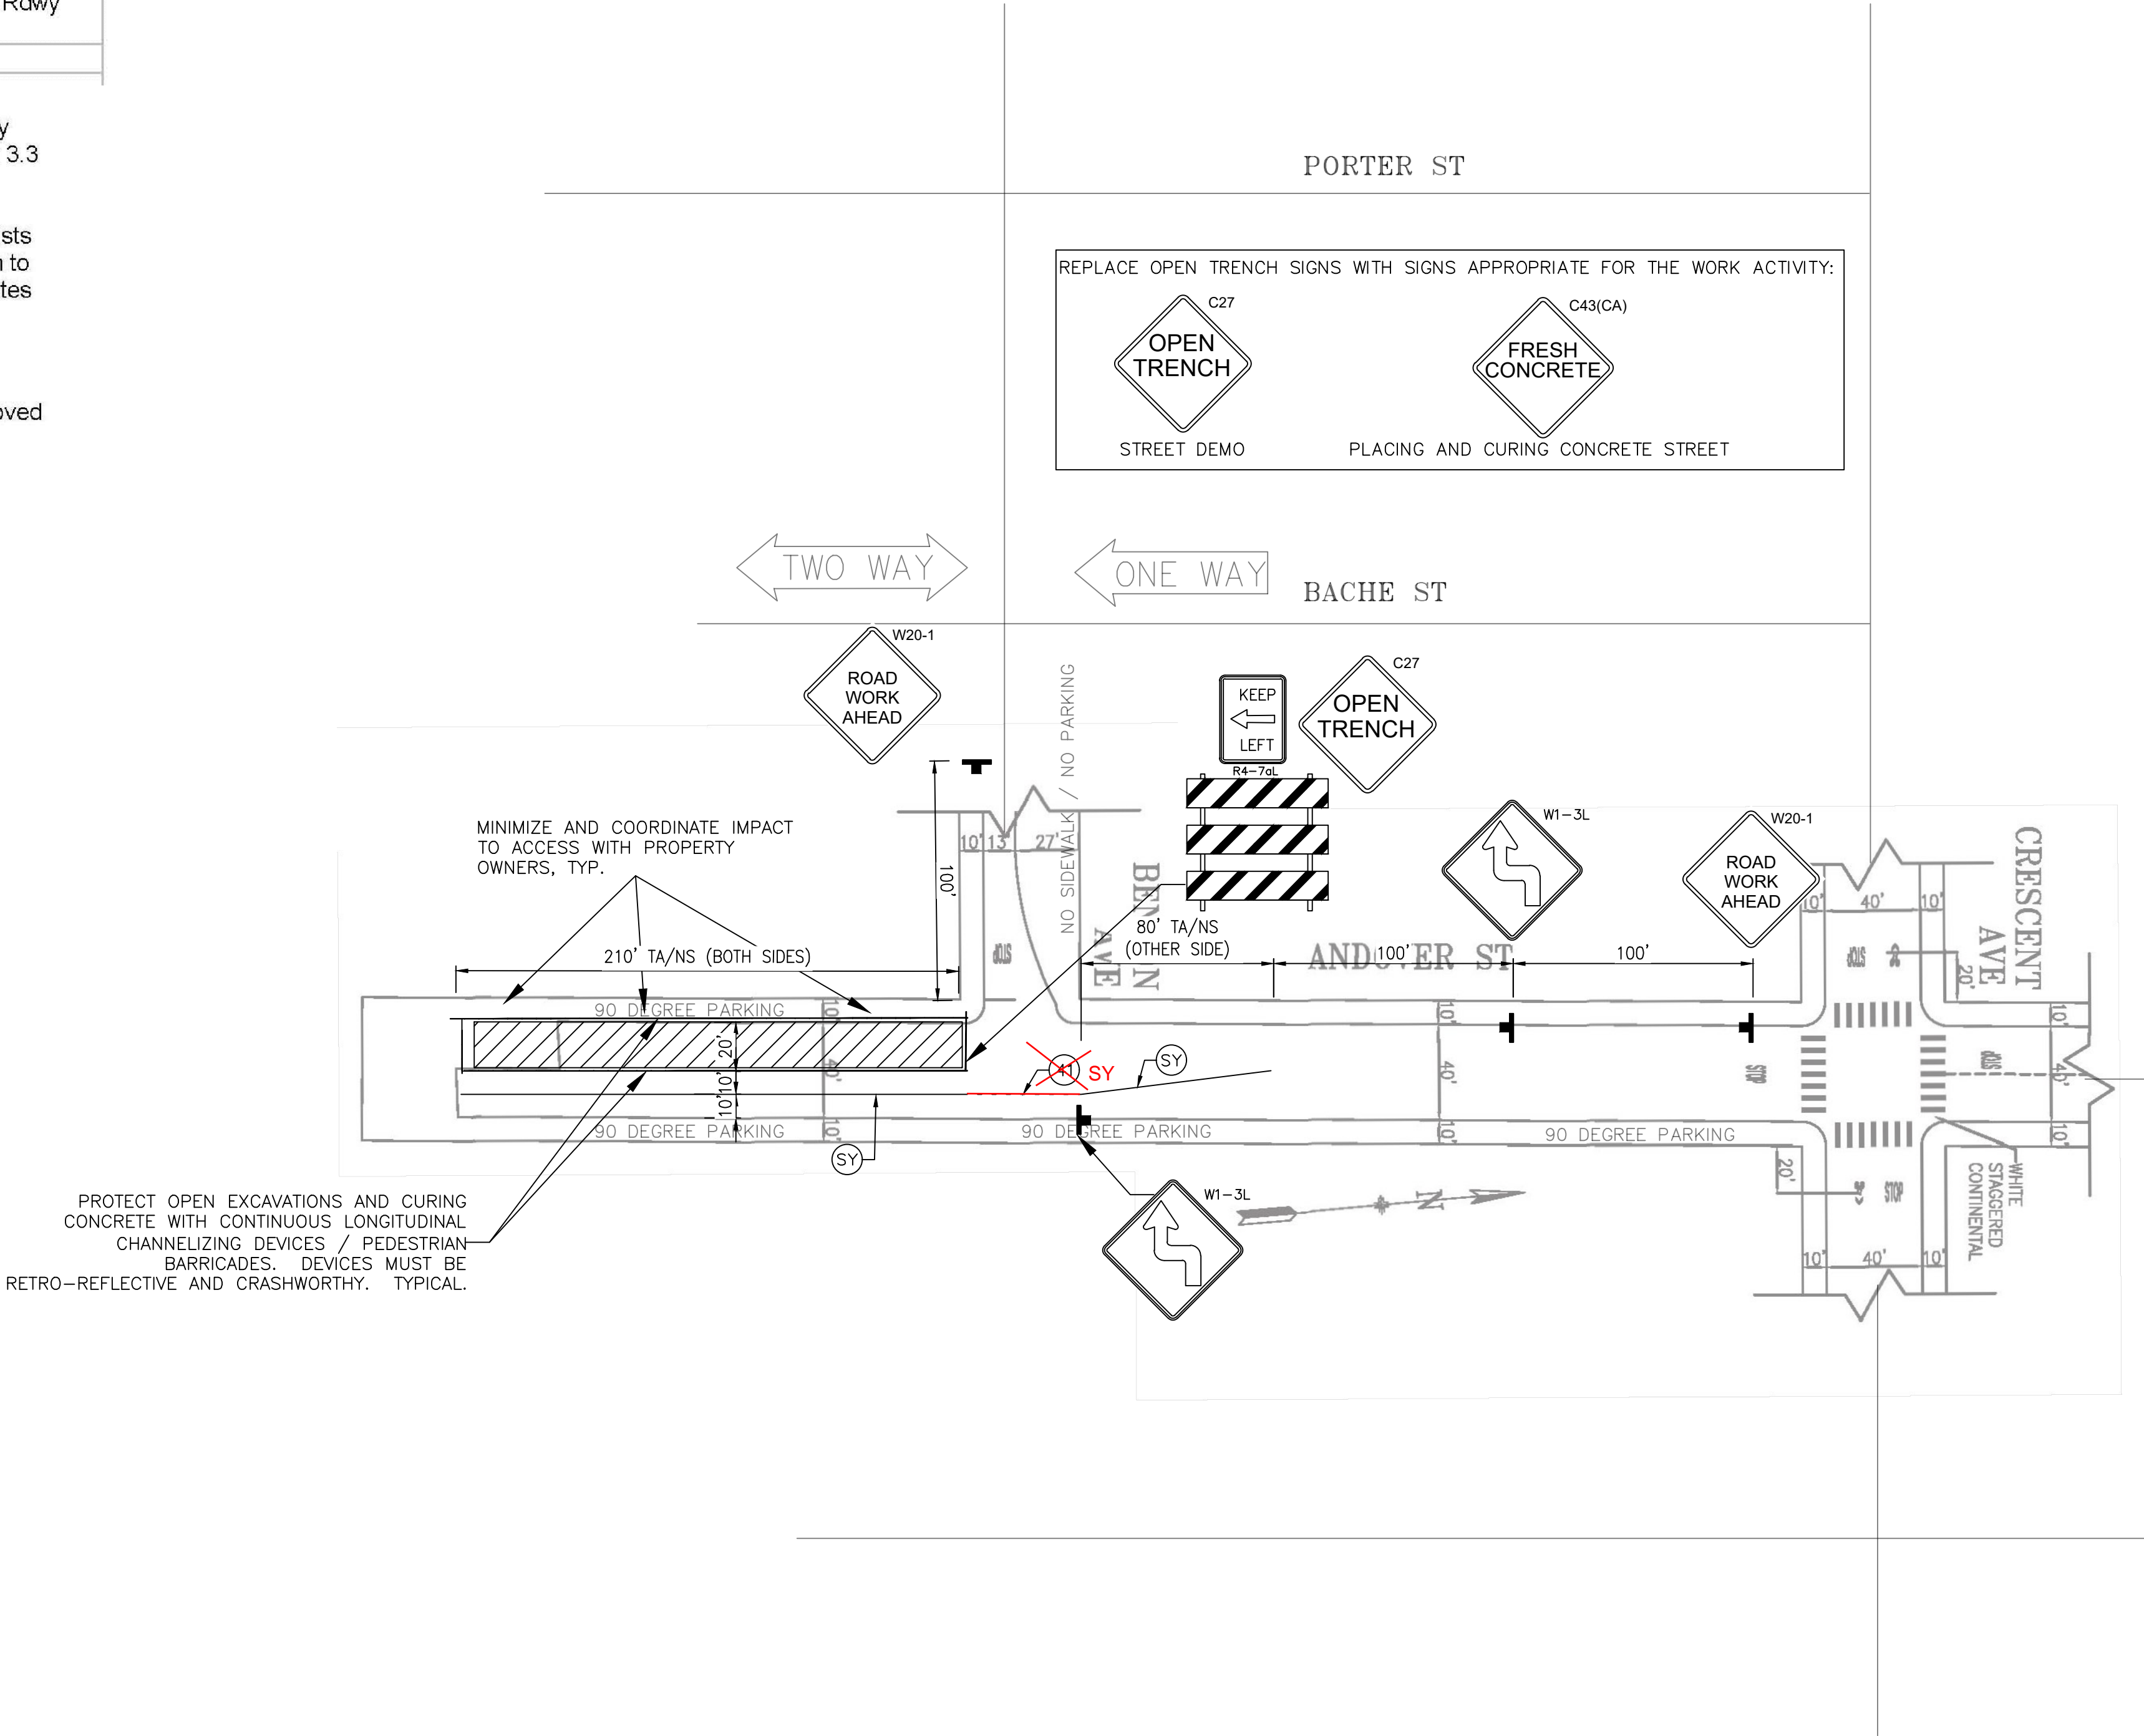

IF THIS SHEET IS NOT 24"x36" , IT IS
A REDUCED PRINT – SCALE ACCORDINGLY

050100150

1" = 50'

GRAPHIC SCALE

Revisions				
No.	Revisions	By	Date	Appr.

BAY-CON
INFRASTRUCTURE

BAY-CON INFRASTRUCTURE

PO BOX 1342

SAN MATEO CA 94401

(415) 580-1441 OFFICE

(415) 329-3240 FAX

INFO@BAY-CON.COM

Key Plan

This document is the property of the engineer and is not to be used without engineer's written permission. Satellite imagery provided by Google Earth.

Engineer Of Record:

PHIL MIESZKOWSKI, PE

REGISTERED PROFESSIONAL ENGINEER

PHILIP M. MIESZKOWSKI

C 76768

EXP. 12/31/2022

CIVIL

STATE OF CALIFORNIA

5/20/2022

DESIGN DOCUMENTS
TEMPORARY TRAFFIC CONTROL

Client

MICHAEL O'SHAUGHNESSY CONSTRUCTION, INC
48 RIVERTON DR
SAN FRANCISCO, CA 94132
(415) 726-3052
OFFICE@MOSCONSTRUCTION.ORG

Owner

SAN FRANCISCO PUBLIC WORKS
49 S VAN NESS AVE, SUITE 1600
SAN FRANCISCO, CA 94103
(628) 271-3139
CONTRACTADMIN.STAFF@SFPD.W.ORG

Project

VARIOUS LOCATIONS NO. 52 PAVEMENT
RENOVATION AND SEWER REPLACEMENT
SAN FRANCISCO, CA
SOURCING ID NO. 0000003758

Sheet Title

TOP FOR CONCRETE STREET
RECONSTRUCTION ON ANDOVER ST FROM
BENTON AVE TO END – WEST SIDE –
WORKING AND NON-WORKING HOURS –
SHEET 46 OF 46

BGI Job	146	Sheet TCP-088
Drwn By	PM	
Chckd By	PM	
Issue Date	05/20/2022	