


Traffic Lane Requirements
Number and Width of Lanes

STREET	TIME	NORTHBOUND	SOUTHBOUND	EASTBOUND	WESTBOUND
CURB RAMP WORK					
PERALTA AVENUE					
Mullen Ave to Franconia St	8AM – 4PM (M-F) At Other Times	1@10' Full Rdwy	1@10' Full Rdwy	-	-
Cross Streets for Peralta Ave					
Mullen Ave Florida St	8AM – 4PM (M-F) At Other Times	-	-	1@10' Full Rdwy	1@10' Full Rdwy

WORKING AND NON-WORKING HOURS – PHASE 1

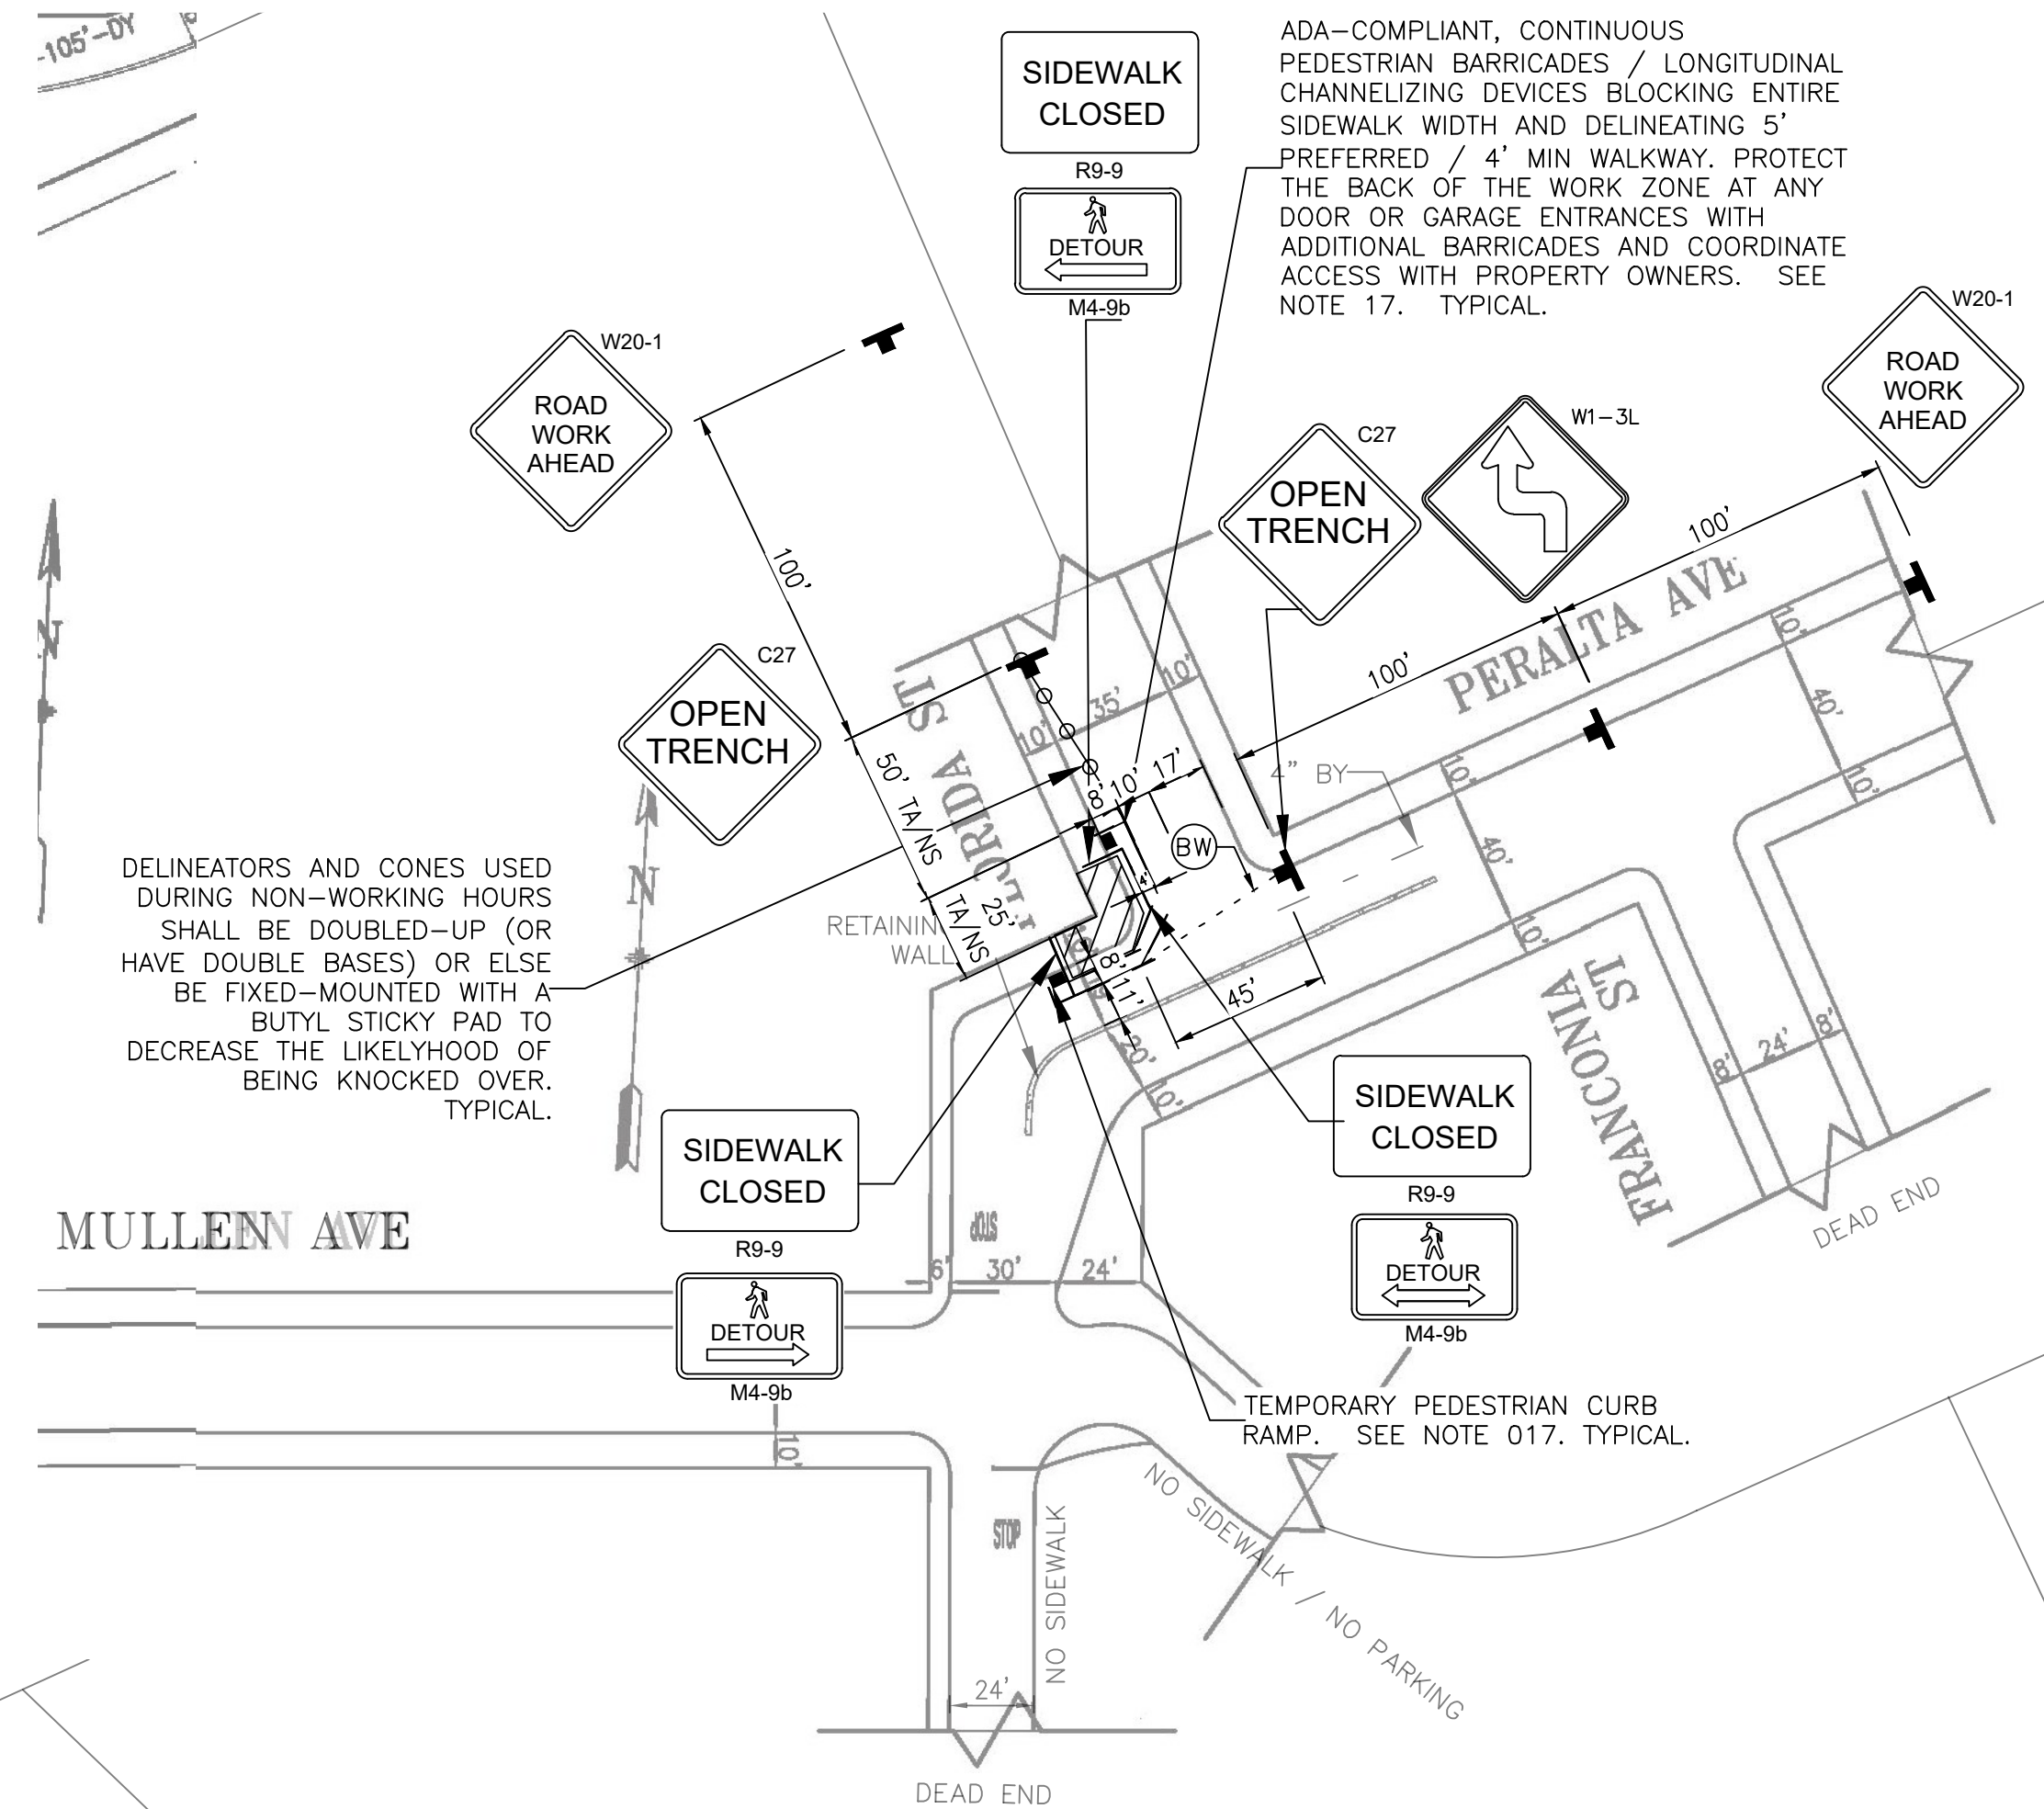

IF THIS SHEET IS NOT 24"x36" , IT IS
A REDUCED PRINT – SCALE ACCORDINGLY

0 50 100 150
1" = 50' GRAPHIC SCALE

Revisions	No.	Revisions	By	Date	Appr.

BAY-CON
INFRASTRUCTURE

BAY-CON INFRASTRUCTURE
PO BOX 1342
SAN MATEO CA 94401
(415) 580-1441 OFFICE
(415) 329-3240 FAX
INFO@BAY-CON.COM

Key Plan

This document is the property of the engineer and is
not to be used without engineer's written permission.
Satellite imagery provided by Google Earth.

Engineer Of Record:
PHIL MIESZKOWSKI, PE



DESIGN DOCUMENTS
TEMPORARY TRAFFIC CONTROL

Client
MICHAEL O'SHAUGHNESSY CONSTRUCTION, INC
48 RIVERTON DR
SAN FRANCISCO, CA 94132
(415) 726-3052
OFFICE@MOSCONSTRUCTION.ORG

Owner
SAN FRANCISCO PUBLIC WORKS
49 S VAN NESS AVE, SUITE 1600
SAN FRANCISCO, CA 94103
(628) 271-3139
CONTRACTADMIN.STAFF@SFPD.PW.ORG


Project
VARIOUS LOCATIONS NO. 52 PAVEMENT
RENOVATION AND SEWER REPLACEMENT
SAN FRANCISCO, CA
SOURCING ID NO. 0000003758

Sheet Title
TRAFFIC CONTROL PLAN FOR CURB RAMP,
SIDEWALK AND CURB & GUTTER
CONSTRUCTION ON PERALTA AVE AT FLORIDA
ST – SHEET 12 OF 17

BCI Job 146
Drwn By PM
Chckd By PM
Issue Date 5/2/2022

Sheet
TCP-038

WORKING AND NON-WORKING HOURS – PHASE 2

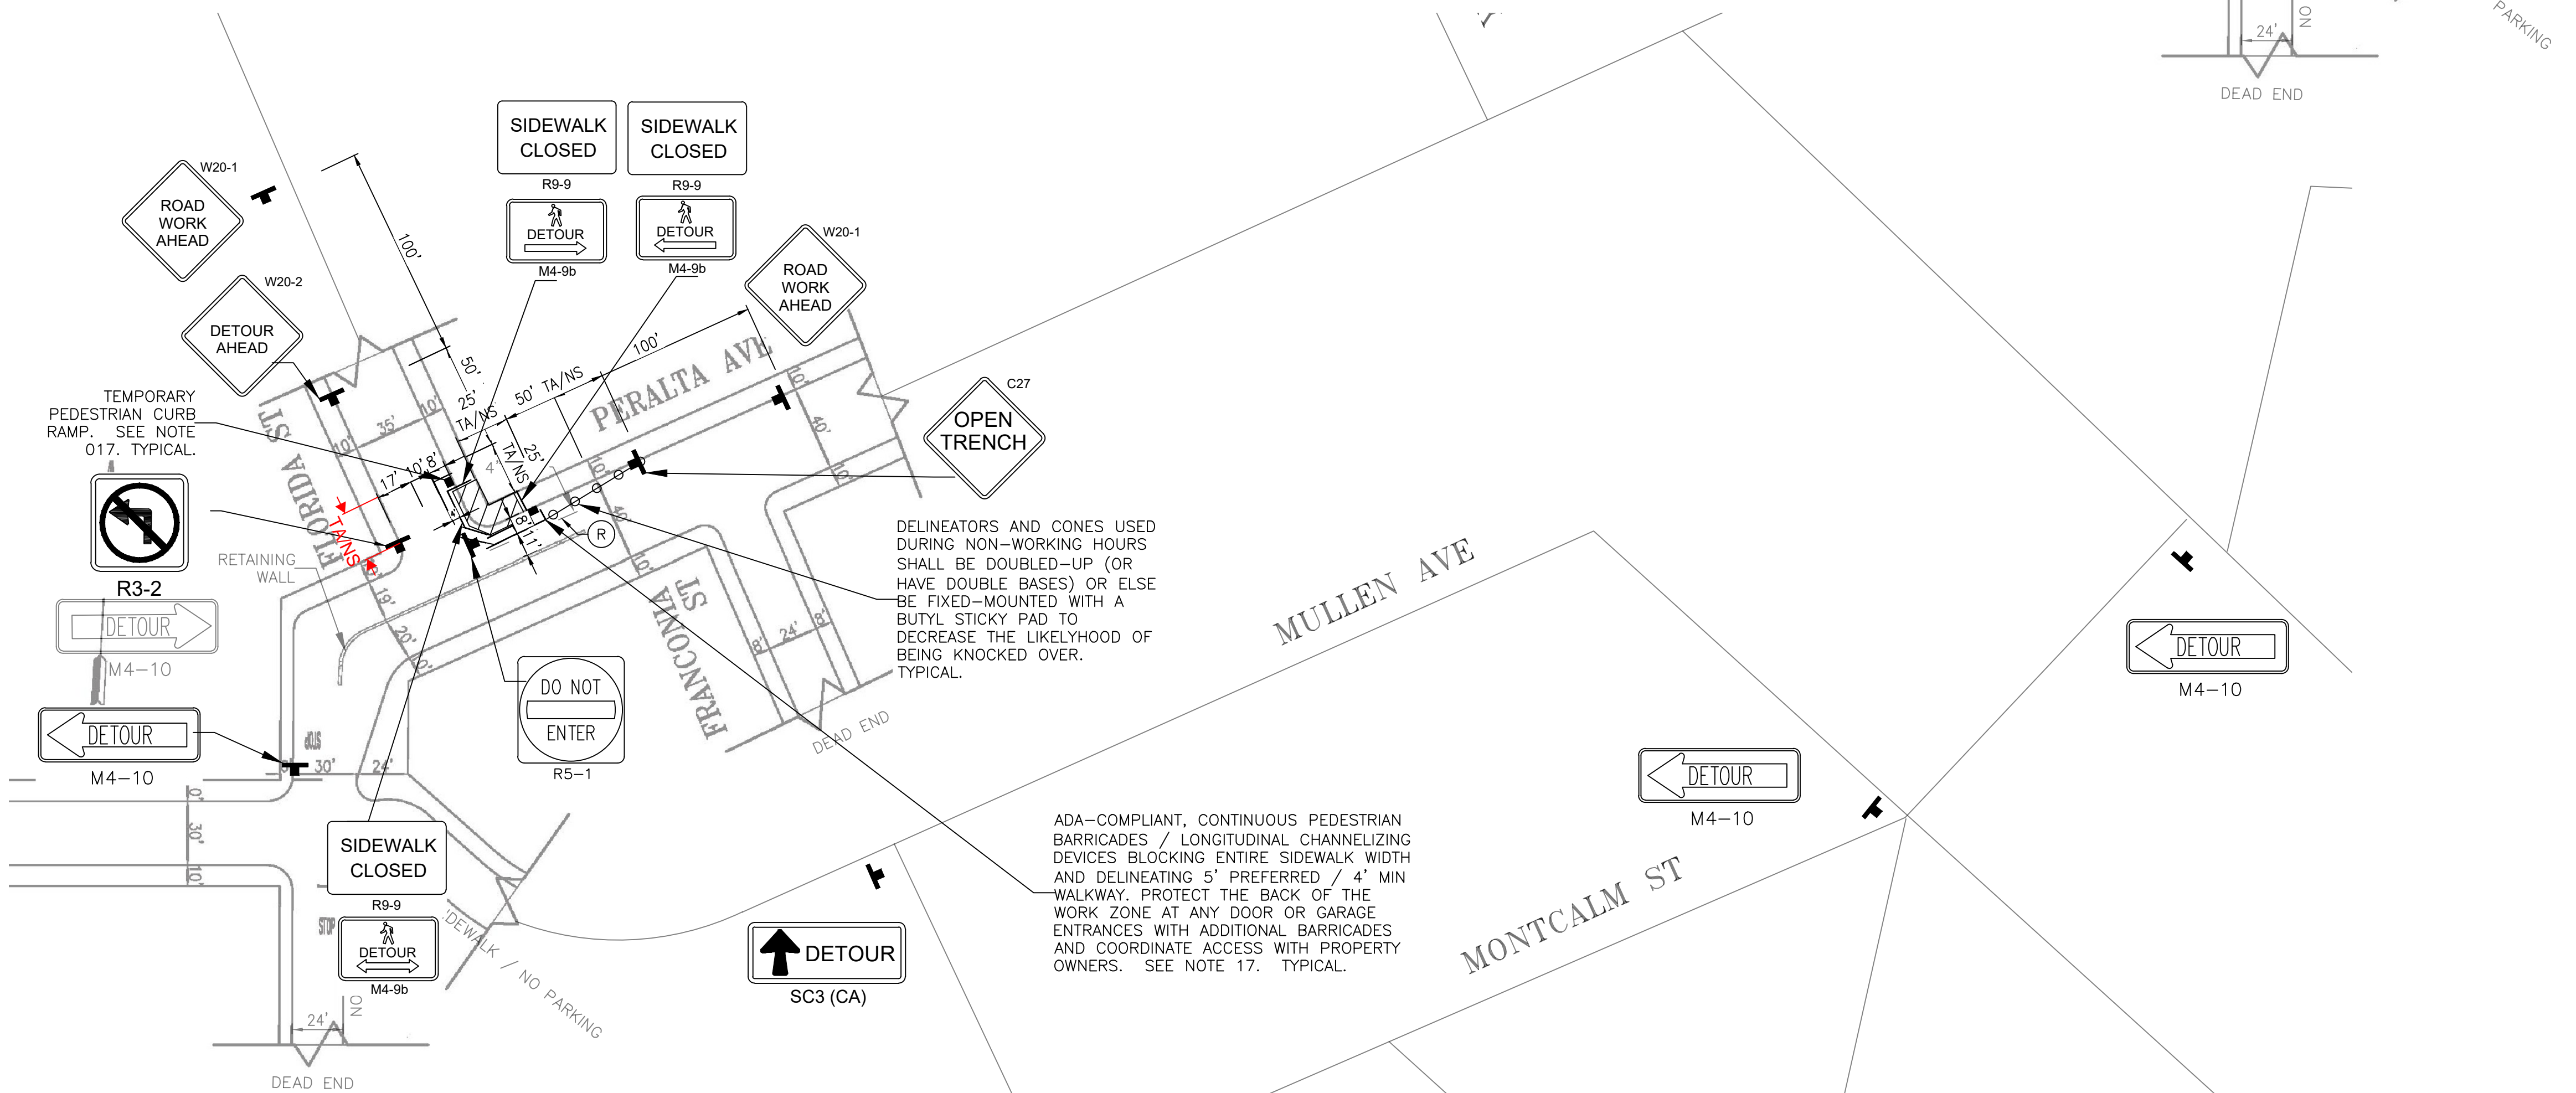

☐ NO EXCEPTIONS TAKEN
☒ MAKE CORRECTIONS NOTED
☐ REJECTED
☐ REVISE AND RESUBMIT
☐ SUBMIT SPECIFIED ITEM(S)

Review is only for general conformance with
the design concept of the project and general
compliance with the requirements of the
contract documents. Any action shown is
subject to the requirements of the plans and
specifications. Contractor's responsibilities
include, but are not limited to, actual
dimensions which shall be confirmed and
correlated at the job site; preferred
fabrication processes and techniques of
construction; coordination of the
contractor's work with that of all other
trades; and the satisfactory performance of
the contractor's work.

Sustainable Streets Division
San Francisco Municipal Transportation Agency
City and County of San Francisco

By: *[Signature]* Date: 5/18/22