

Traffic Lane Requirements  
Number and Width of Lanes


STREET	TIME	NORTHBOUND	SOUTHBOUND	EASTBOUND	WESTBOUND
GRINDING, PAVING, CONCRETE STREET, & BASE REPAIR WORK					
ANDOVER STREET					
end to Crescent Ave	8AM – 4PM (M-F) At Other Times	1@11' Full Rdwy	1@11' Full Rdwy	-	-
Cross Streets for Andover St					
Benton Ave	8AM – 4PM (M-F) At Other Times	-	-	1@12' Full Rdwy	-
Crescent Ave 8*(MC)	At All Times	-	-	Full Rdwy	Full Rdwy

\* The Contractor shall not prevent or delay the operation of mass transit vehicles at any time. TC = Trolley Coach, MC = Motor Coach, MM = SFMTA Metro. See Subsection 3.3 MASS TRANSIT VEHICLES for more information.

β The Contractor shall perform the appropriate measures to ensure the safety of bicyclists on ALL streets on which there is construction. Contractors shall pay special attention to streets that are on the Bicycle Route Network. See Blue Book Section 9: Bicycle Routes or on the internet at:

<https://www.sfmta.com/maps/san-francisco-bike-network-map>

The Contractor shall install "Bicyclists Allowed Use of Full Lane" signs, or other approved equal, on streets with bicycle lanes during construction.

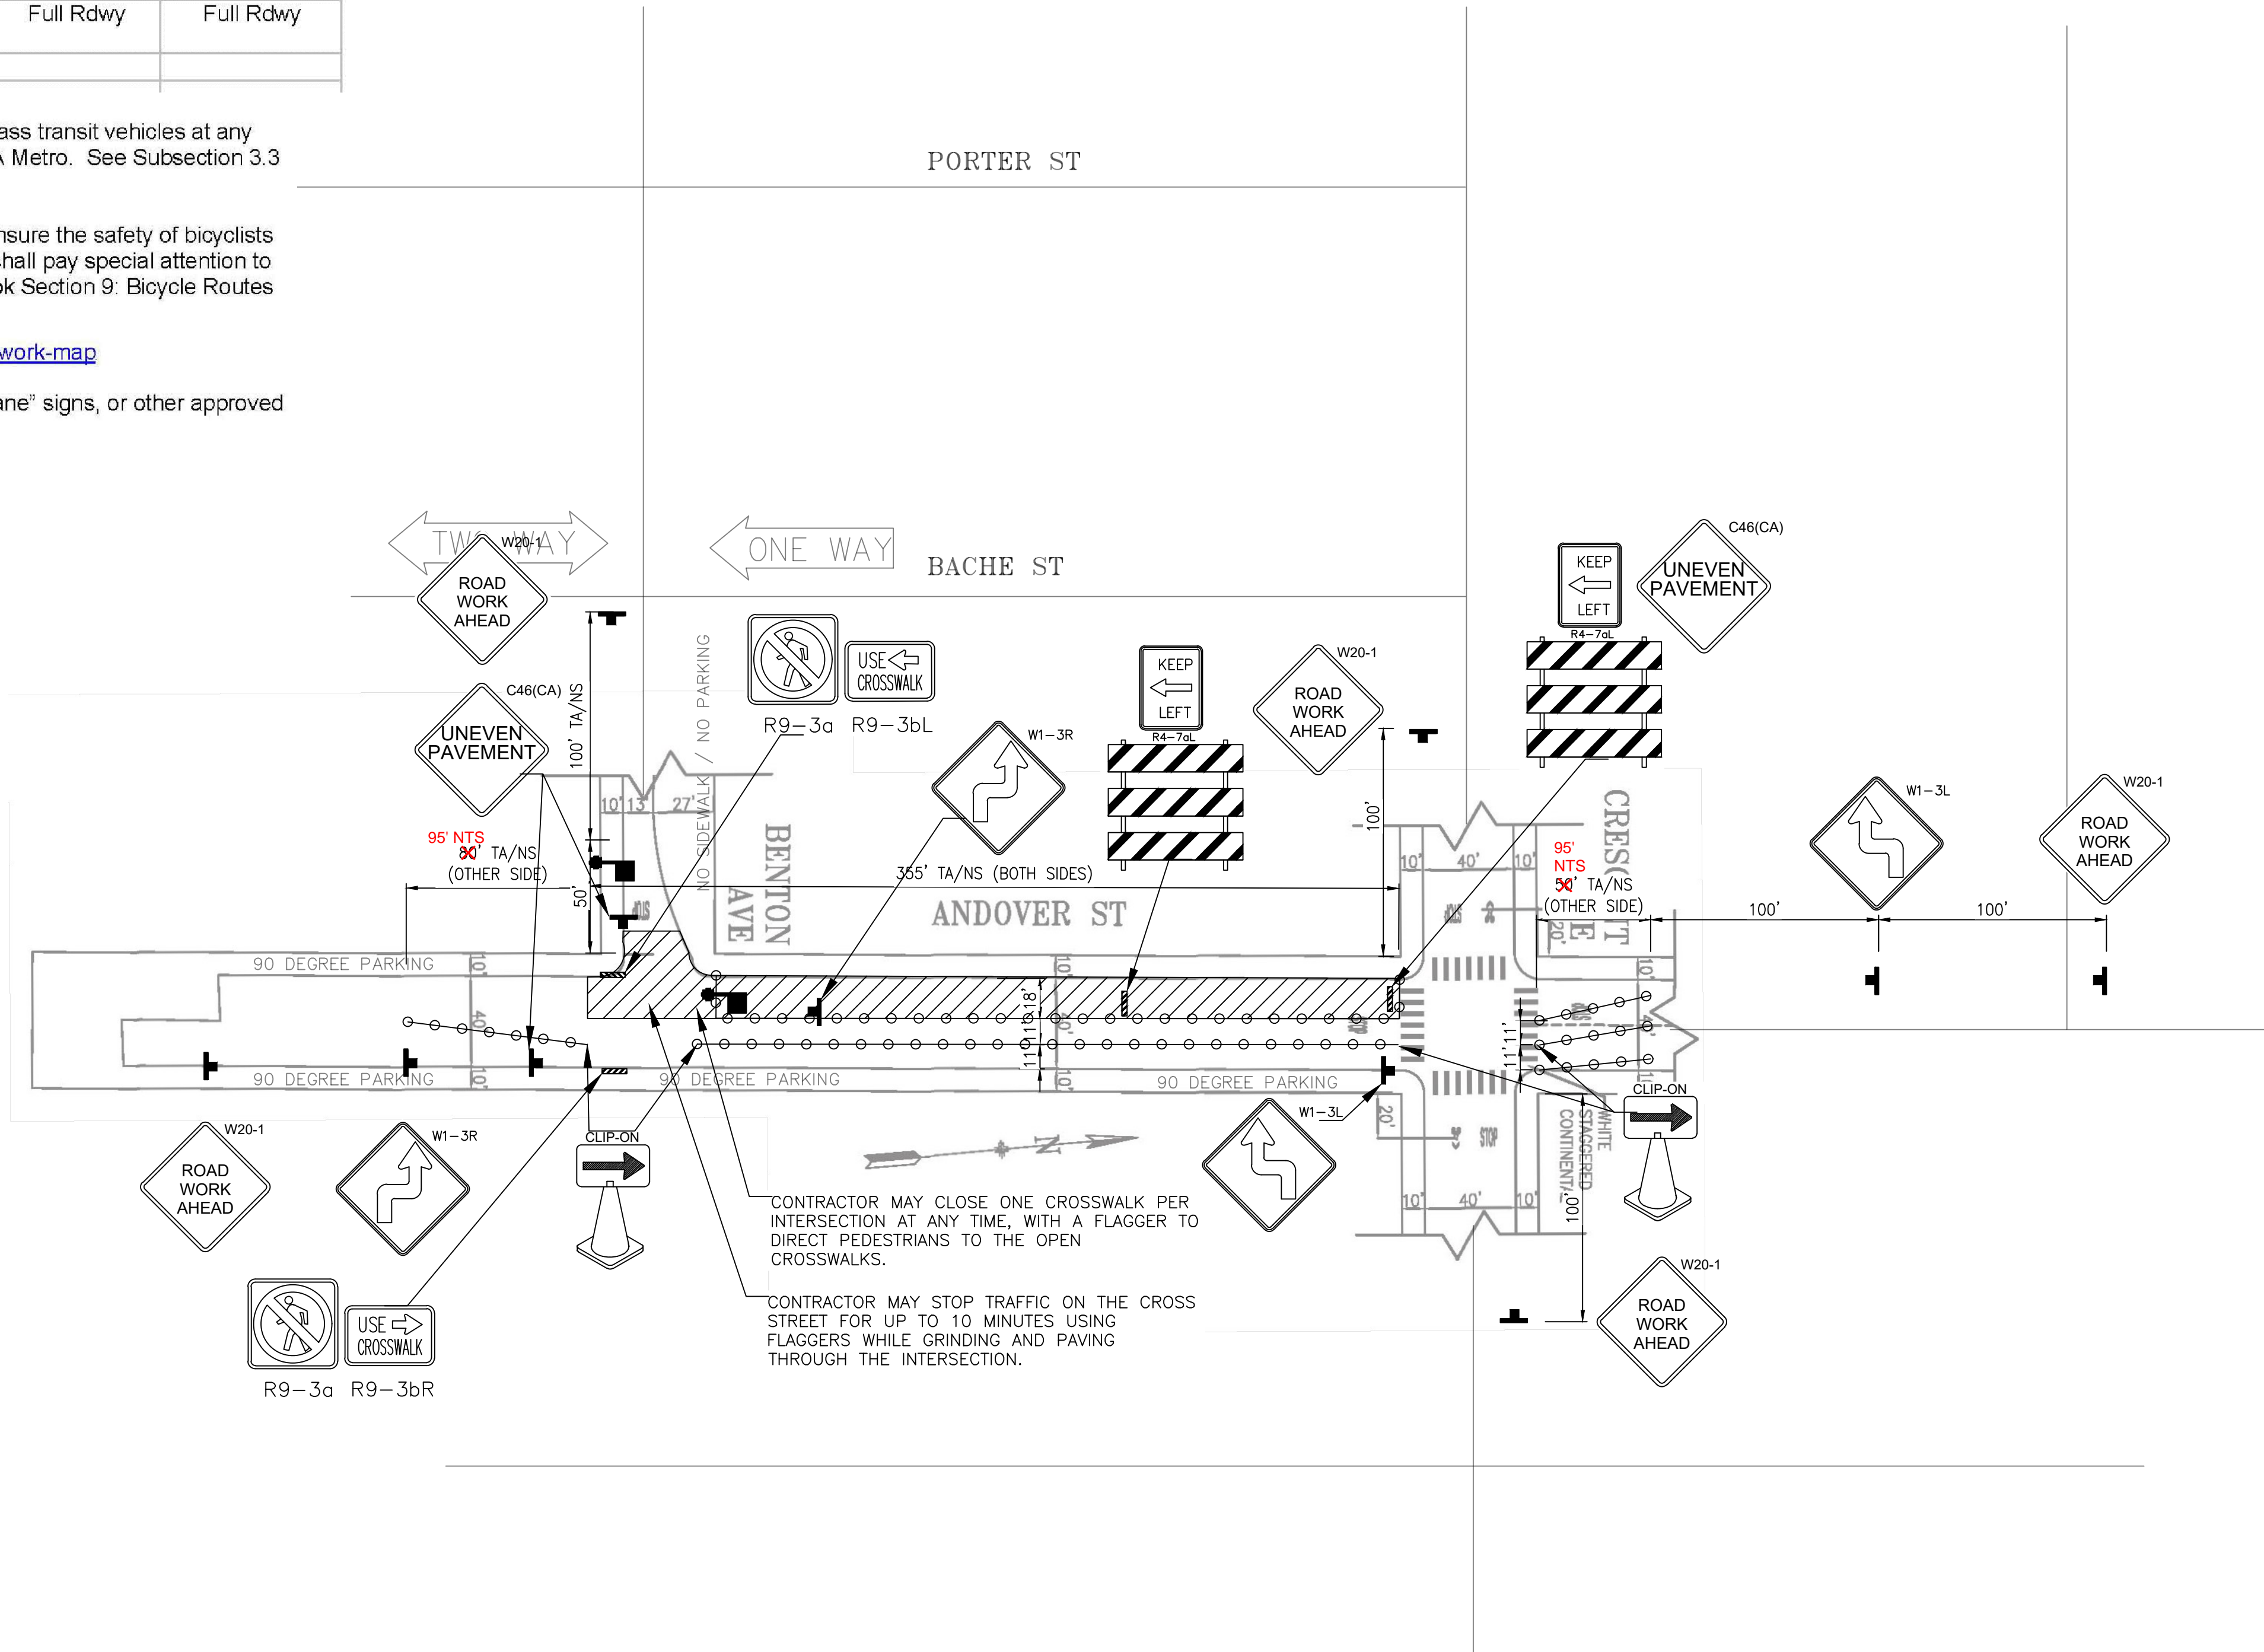

<input type="checkbox"/>	NO EXCEPTIONS TAKEN
<input checked="" type="checkbox"/>	MAKE CORRECTIONS NOTED
<input type="checkbox"/>	REJECTED
<input type="checkbox"/>	REVISE AND RESUBMIT
<input type="checkbox"/>	SUBMIT SPECIFIED ITEM(S)

Review is only for general conformance with the design concept of the project and general compliance with the requirements of the contract documents. Any action shown is subject to the requirements of the plans and specifications. Contractor's responsibilities include, but are not limited to actual dimensions which shall be confirmed and correlated at the job site; preferred fabrication processes and techniques of construction; coordination of the contractor's work with that of all other trades; and the satisfactory performance of the contractor's work.

Sustainable Streets Division  
San Francisco Municipal Transportation Agency  
City and County of San Francisco

By: *[Signature]* Date: 8/1/22

IF THIS SHEET IS NOT 24"x36" , IT IS  
A REDUCED PRINT – SCALE ACCORDINGLY

0 50 100 150  
1" = 50' GRAPHIC SCALE

Revisions				
No.	Revisions	By	Date	Appr.

BAY-CON INFRASTRUCTURE  
PO BOX 1342  
SAN MATEO CA 94401  
(415) 580-1441 OFFICE  
(415) 329-3240 FAX  
INFO@BAY-CON.COM

Key Plan

This document is the property of the engineer and is not to be used without engineer's written permission. Satellite imagery provided by Google Earth.

Engineer Of Record:  
PHIL MIESZKOWSKI, PE

6/13/2022

DESIGN DOCUMENTS  
TEMPORARY TRAFFIC CONTROL

Client  
MICHAEL O'SHAUGHNESSY CONSTRUCTION, INC  
48 RIVERTON DR  
SAN FRANCISCO, CA 94132  
(415) 726-3052  
OFFICE@MOSCONSTRUCTION.ORG

Owner  
SAN FRANCISCO PUBLIC WORKS  
49 S VAN NESS AVE, SUITE 1600  
SAN FRANCISCO, CA 94103  
(628) 271-3139  
CONTRACTADMIN.STAFF@SFPD.WORKS

Project  
VARIOUS LOCATIONS NO. 52 PAVEMENT  
RENOVATION AND SEWER REPLACEMENT  
SAN FRANCISCO, CA  
SOURCING ID NO. 000003758

Sheet Title  
TCP FOR GRIND & PAVE ON ANDOVER ST  
FROM BENTON AVE TO CRESCENT AVE –  
WEST SIDE

BGI Job	146	Sheet	11	of	11
Drawn By	PM	TCP-099			
Checked By	PM				
Issue Date	6/13/22				