


1" = 50'

GRAPHIC SCALE

Revisions				
No.	Revisions	By	Date	Appr.

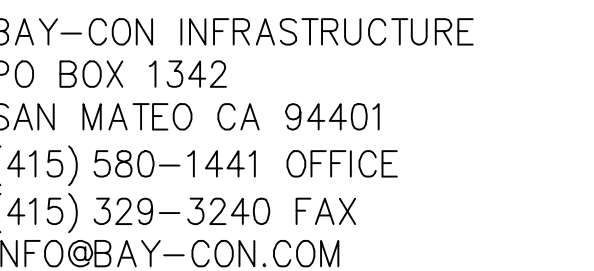

y Plan

This document is the property of the engineer and is not to be used without engineer's written permission. Satellite imagery provided by Google Earth.

Engineer Of Record:
PHIL MIESZKOWSKI, PE

DESIGN DOCUMENTS
TEMPORARY TRAFFIC CONTROL

CHAE O'SHAUGHNESSY CONSTRUCTION, INC
RIVERTON DR
SAN FRANCISCO, CA 94132
(415) 726-3052
OFFICE@MOSCONSTRUCTION.ORG
ner
SAN FRANCISCO PUBLIC WORKS
1500 VAN NESS AVE, SUITE 1600
SAN FRANCISCO, CA 94103
(415) 271-3139
CONTACTADMIN.STAFF@SFPDW.ORG
ject
VARIIOUS LOCATIONS NO. 52 PAVEMENT
INNOVATION AND SEWER REPLACEMENT
SAN FRANCISCO, CA
PURCHING ID NO. 0000003758

Sheet Title
TEMPORARY TRAFFIC CONTROL PLAN FOR
POWER MAIN INSTALLATION ON COSO AVE
FROM PROSPECT AVE TO WINFIELD ST -
SHEET 2 OF 2

Job	146
Drawn By	PM
Checked By	PM
Issue Date	3/7/2022
Sheet	
TCP-006	

- | | |
|--------------------------|----------------------------|
| <input type="checkbox"/> | NO EXCEPTIONS TAKEN |
| <input type="checkbox"/> | MAKE CORRECTIONS NOTED |
| <input type="checkbox"/> | REJECTED |
| <input type="checkbox"/> | REVISED AND RESUBMIT |
| <input type="checkbox"/> | SUBMIT SPECIALIZED ITEM(S) |

Review is only for general correspondence with the design concept of the project and general compliance with the requirements of the contract documents. Any action shown is subject to the requirements of the plans and specifications. Contractor's responsibilities include, but are not limited to actual dimensions which shall be confirmed and correlated to the site; proper prefabrication processes and techniques of construction; coordination of the contractor's work with that of all other trades and the satisfactory performance of the contractor's work.

Sustainable Streets Division
 San Francisco Municipal Transportation Agency
 City and County of San Francisco

BY: S. Wong / S. Chan Date: 4/11/2022