

Traffic Lane Requirements Number and Width of Lanes

STREET	TIME	NORTHBOUND	SOUTHBOUND	EASTBOUND	WESTBOUND
GRINDING, PAVING, CONCRETE STREET, & BASE REPAIR WORK					
<u>ANDOVER STREET</u>					
end to Crescent Ave	8AM – 4PM (M-F) At Other Times	1@11' Full Rdwy	1@11' Full Rdwy	- -	- -
<u>Cross Streets for Andover St</u>					
Benton Ave	8AM – 4PM (M-F) At Other Times	- -	- -	1@12' Full Rdwy	- -
Crescent Ave β *(MC)	At All Times	-	-	Full Rdwy	Full Rdwy

* The Contractor shall not prevent or delay the operation of mass transit vehicles at any time. TC = Trolley Coach, MC = Motor Coach, MM = SFMTA Metro. See Subsection 3.3 MASS TRANSIT VEHICLES for more information.

β The Contractor shall perform the appropriate measures to ensure the safety of bicyclists on ALL streets on which there is construction. Contractors shall pay special attention to streets that are on the Bicycle Route Network. See Blue Book Section 9: Bicycle Routes or on the internet at:

<https://www.sfmta.com/maps/san-francisco-bike-network-map>


The Contractor shall install "Bicyclists Allowed Use of Full Lane" signs, or other approved equal, on streets with bicycle lanes during construction.

☒ NO EXCEPTIONS TAKEN
☒ MAKE CORRECTIONS NOTED
☒ REJECTED
☒ REVISE AND RESUBMIT
☒ SUBMIT SPECIFIED ITEM(S)

Review is only for general conformance with the design concept of the project and general conformance with the specifications of the contract documents. Any action shown is subject to the requirements of the plans and specifications. The contractor's responsibilities include, but are not limited to actual dimensions which shall be confirmed and verified by the contractor, preferred fabrication processes and techniques of construction; coordination of the construction work with other trades; and the satisfactory performance of the contractor's work.

Sustainable Streets Division
 San Francisco Municipal Transportation Agency
 City and County of San Francisco

By: *g. j. [signature]* Date: 7/25/22

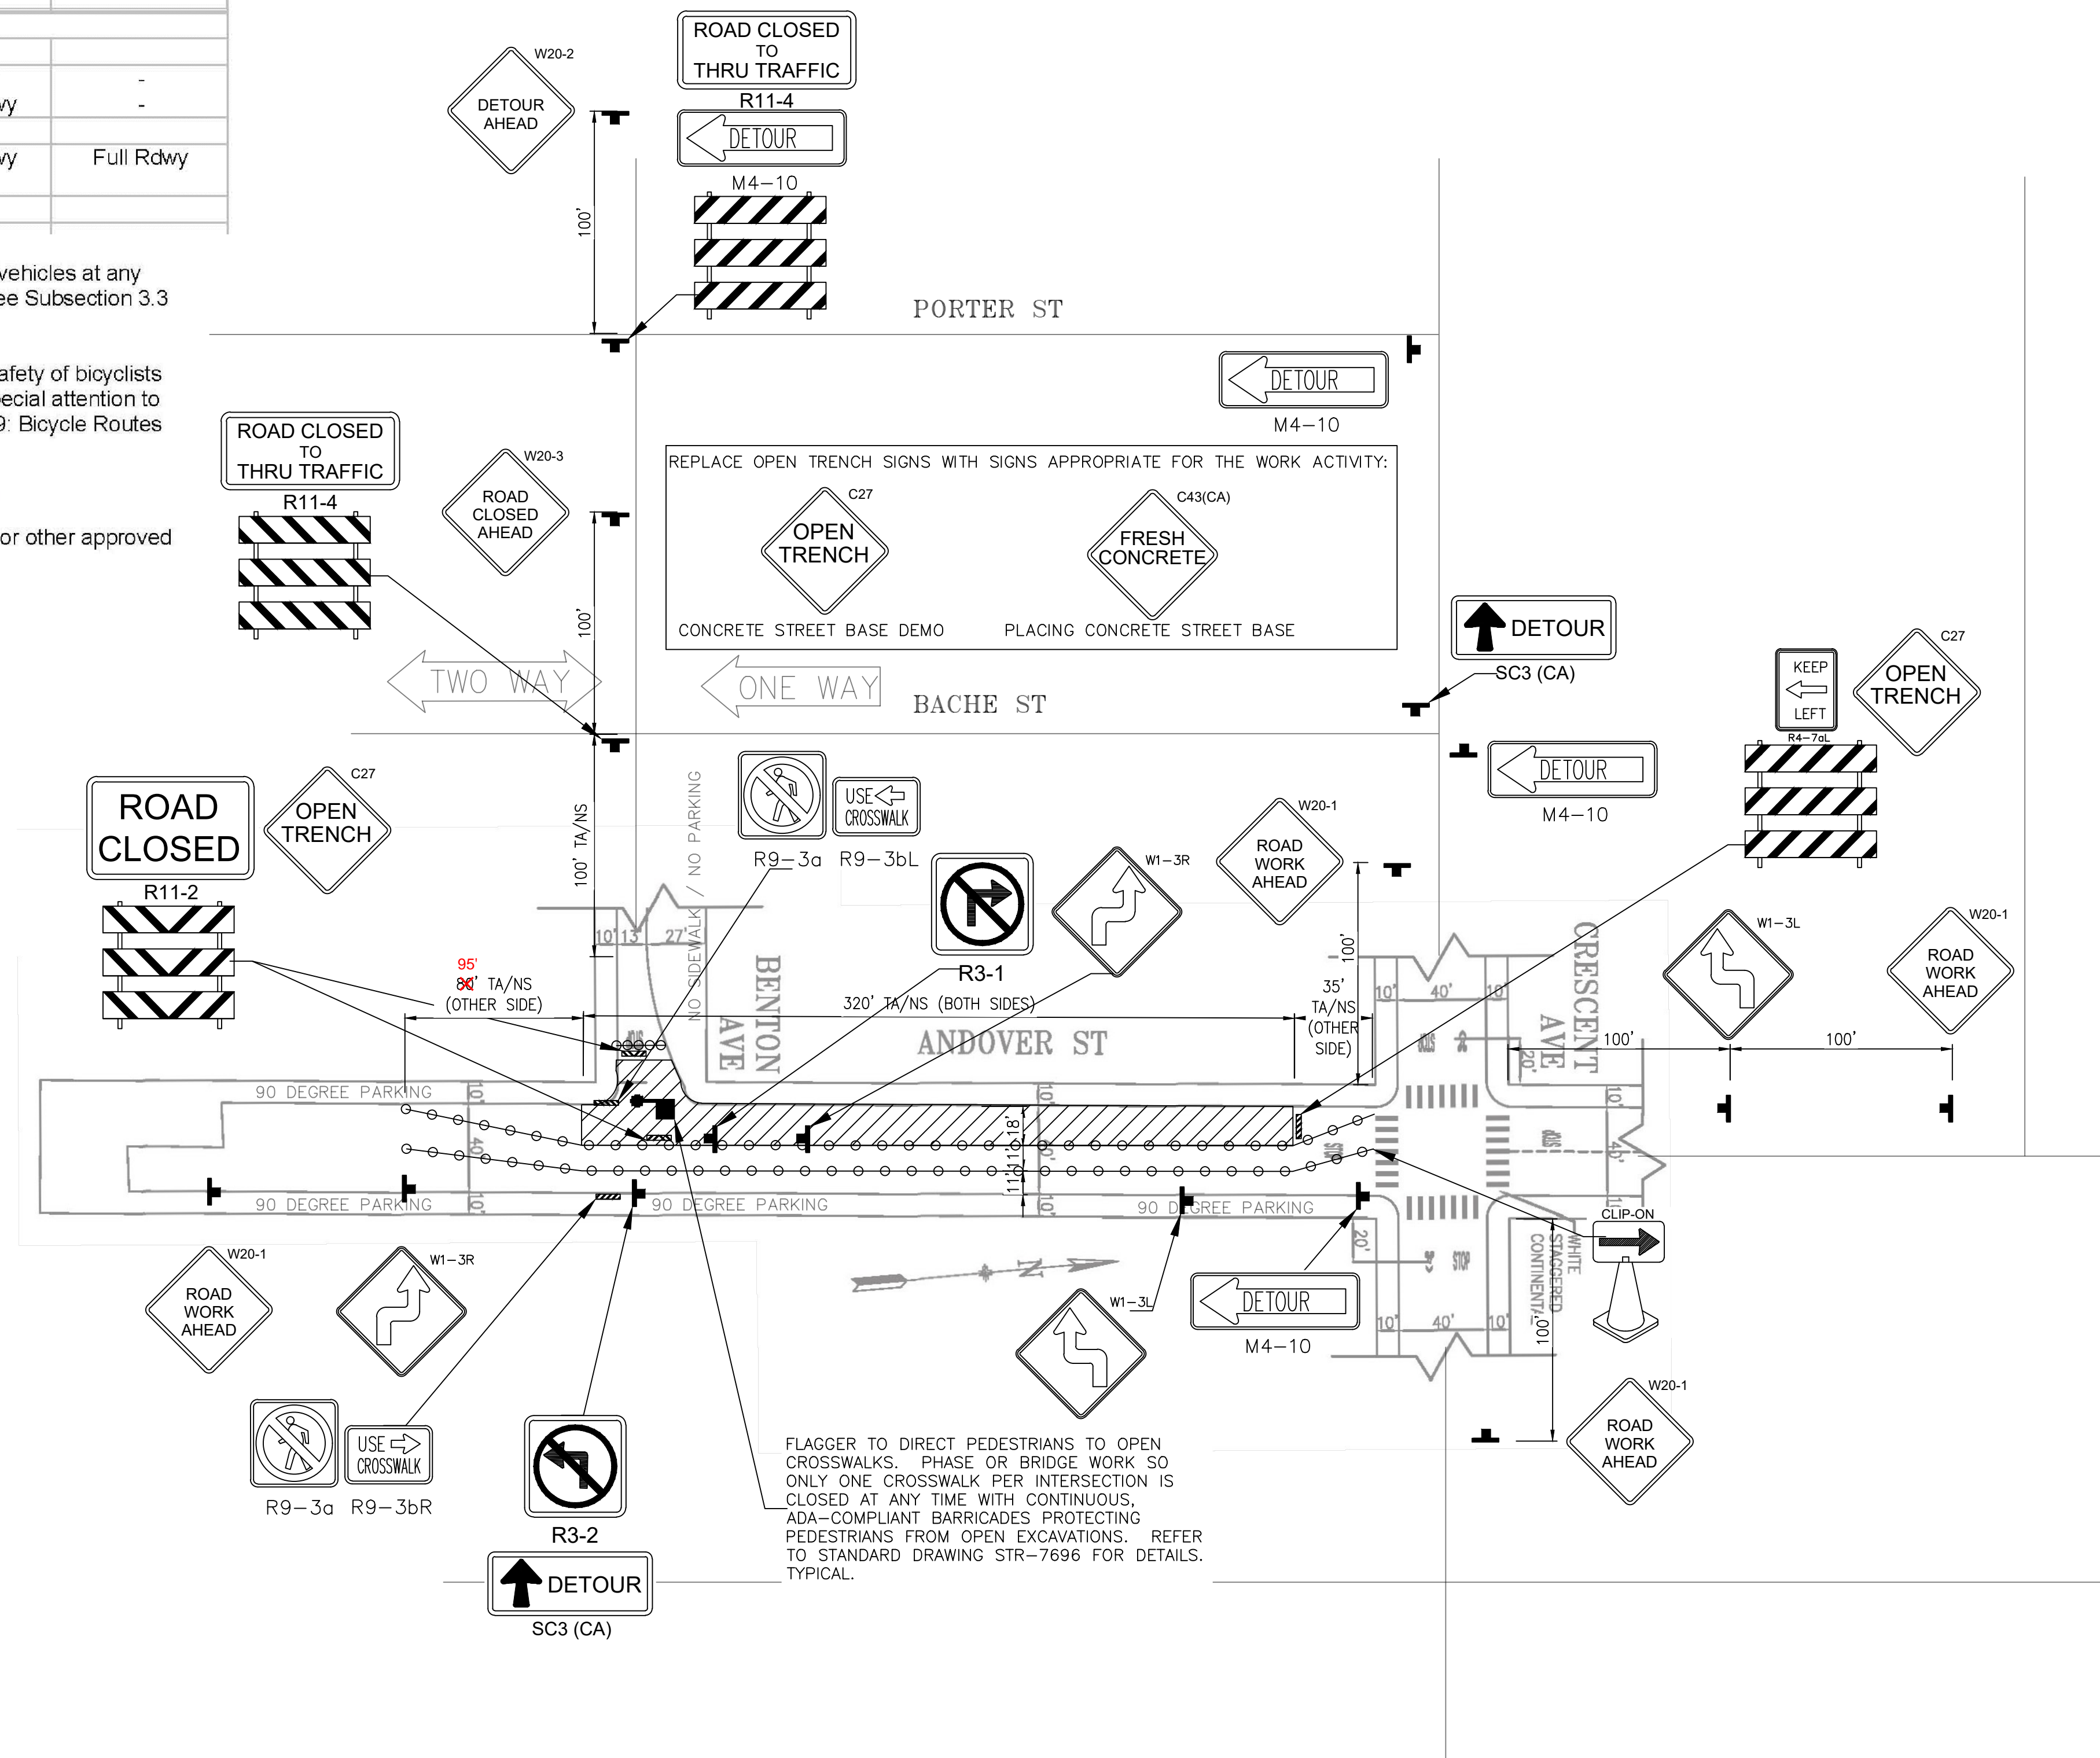

IF THIS SHEET IS NOT 24"x36" , IT IS
A REDUCED PRINT - SCALE ACCORDINGLY

[illegible]

BAY-CON INFRASTRUCTURE
PO BOX 1342
SAN MATEO CA 94401
(415) 580-1441 OFFICE
(415) 329-3240 FAX
INFO@BAY-CON.COM

Key Plan

This document is the property of the engineer and is not to be used without engineer's written permission. Satellite imagery provided by Google Earth.

Engineer Of Record:
PHIL MIESZKOWSKI, PE

DESIGN DOCUMENTS
TEMPORARY TRAFFIC CONTROL

Client
MICHAEL O'SHAUGHNESSY CONSTRUCTION, INC
48 RIVERTON DR
SAN FRANCISCO, CA 94132
(415) 726-3052
OFFICE@MOSCONSTRUCTION.ORG

Owner
SAN FRANCISCO PUBLIC WORKS
49 S VAN NESS AVE, SUITE 1600
SAN FRANCISCO, CA 94103
(626) 271-3139
CONTRACTADMIN.STAFF@SFPDPO.ORG

Project
VARIOUS LOCATIONS NO. 52 PAVEMENT
RENOVATION AND SEWER REPLACEMENT
SAN FRANCISCO, CA
SOURCING ID NO. 0000003758

Sheet Title
TCP FOR CONCRETE STREET BASE REPAIR
ON ANDOVER ST FROM BENTON AVE TO
CRESCENT AVE (CONTINUED) - SHEET 44
OF 46

BCI Job 146

Drwn By PM

Chckd By PM

Issue Date 05/20/2022

Sheet

TCP-086