Traffic Lane Requirements
Number and Width of Lanes

STREET	TIME	NORTHBOUND	SOUTHBOUND	EASTBOUND	WESTBOUND
GRINDING, PAVING, CONCRETE STREET, & BASE REPAIR WORK					
PERALTA AVENUE					
Mullen Ave to Franconia St	8AM – 4PM (M-F)	-	-	1@10'	1@10'
	At Other Times	-	-	Full Rdwy	Full Rdwy
Cross Streets for Peralta Ave					
Florida St	8AM – 4PM (M-F)	1@10'	1@10'	-	-
	At Other Times	Full Rdwy	Full Rdwy	-	-

REPLACE OPEN TRENCH SIGNS WITH SIGNS APPROPRIATE FOR THE WORK ACTIVITY:

C27 OPEN TRENCH — STREET DEMO

C43(CA) FRESH CONCRETE — PLACING AND CURING CONCRETE STREET

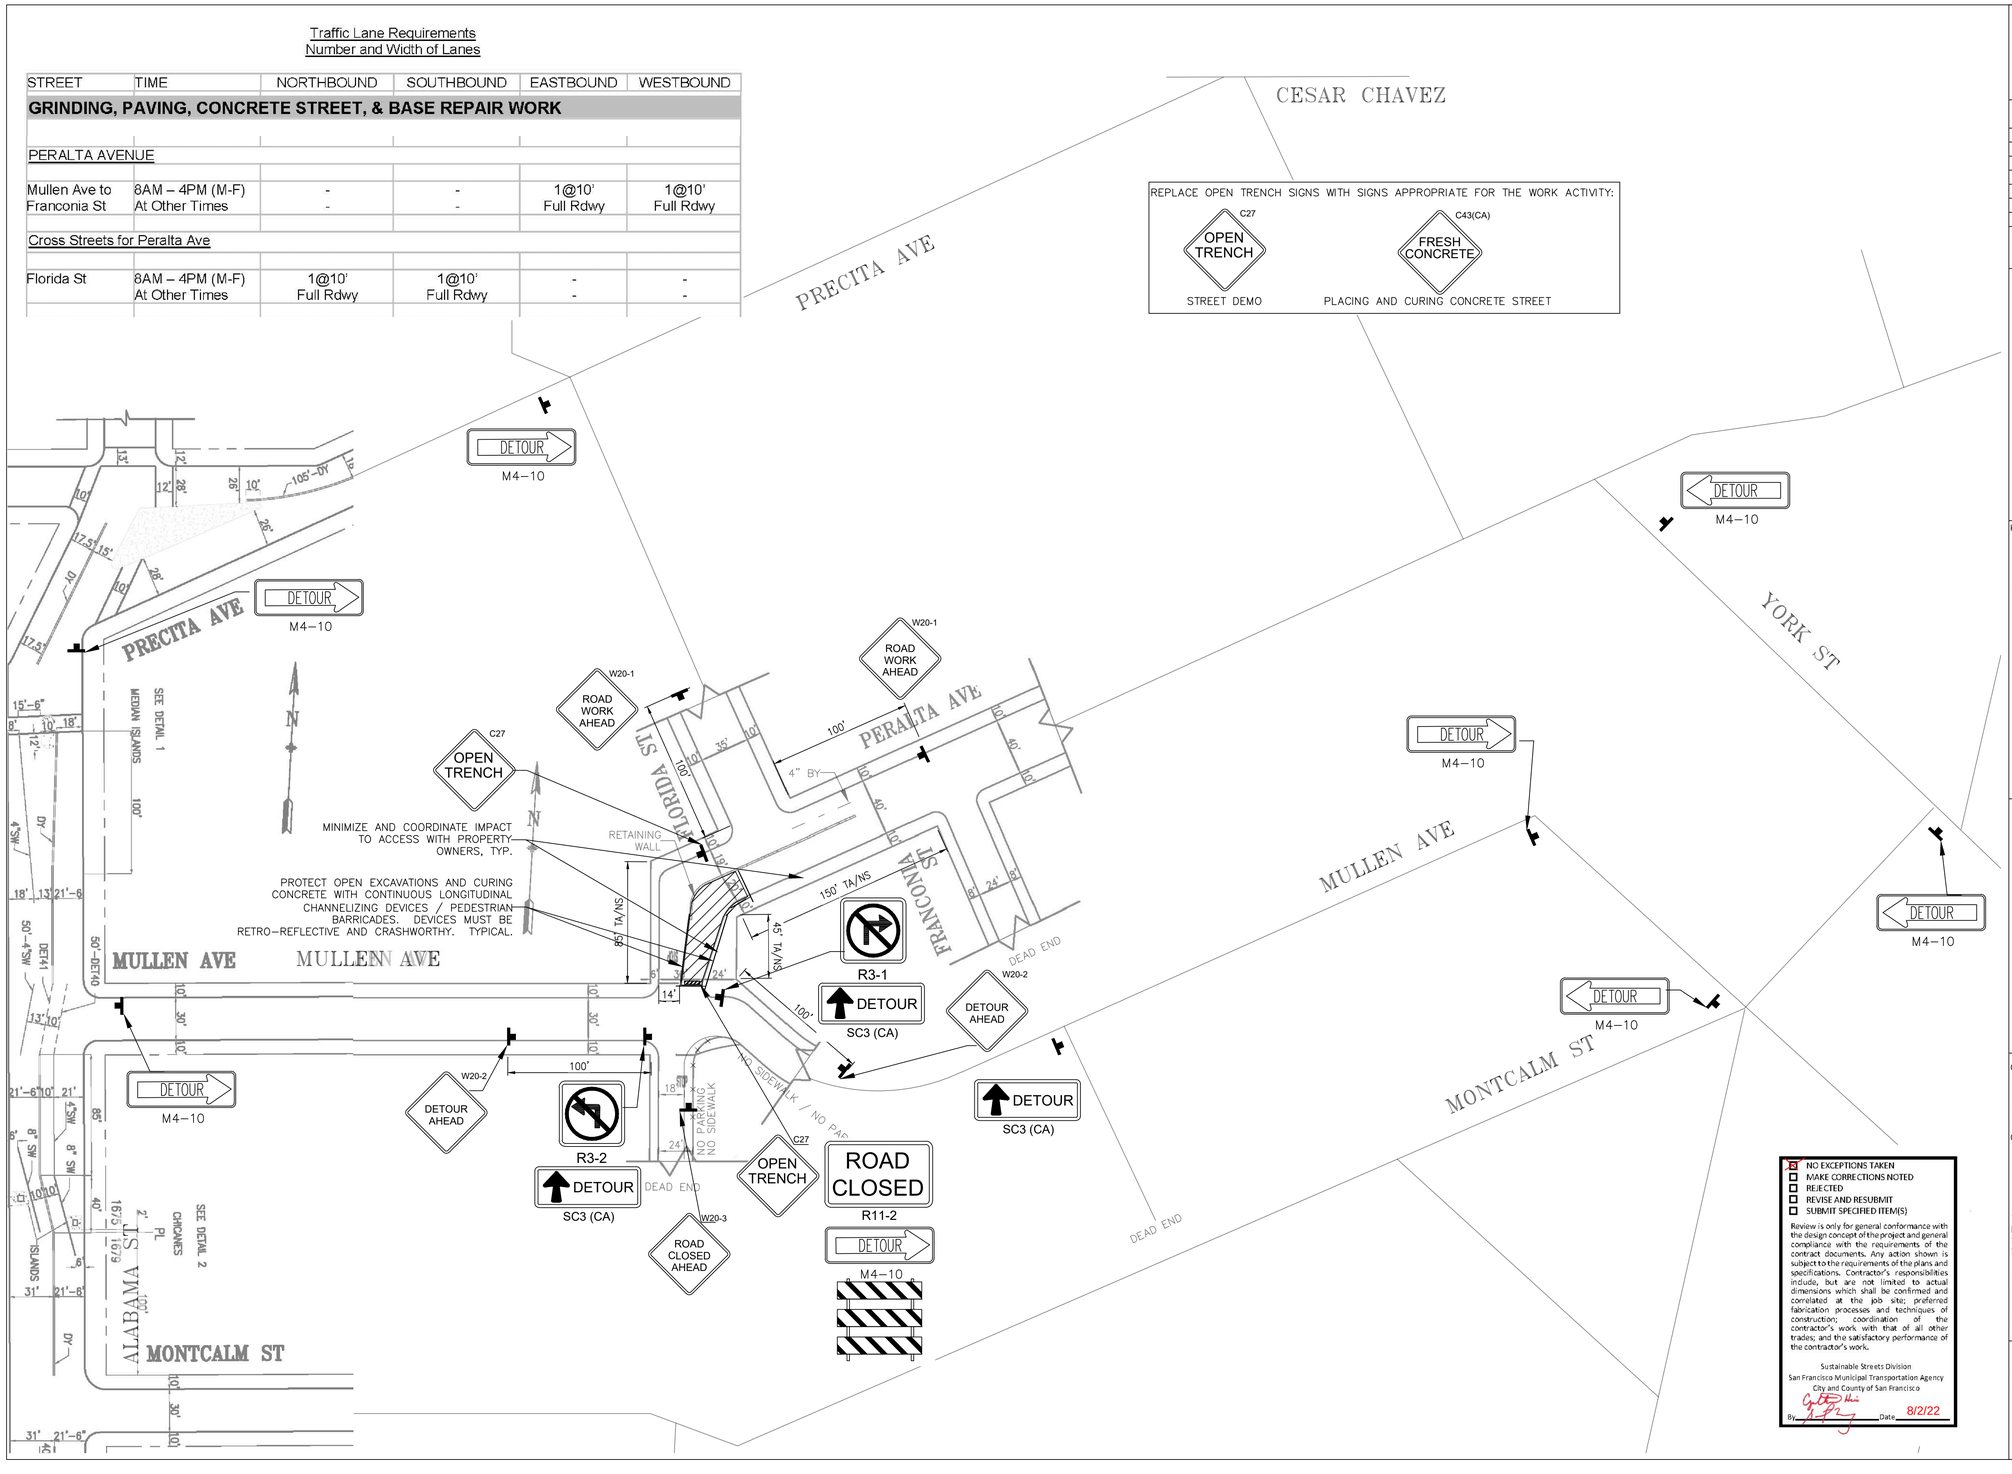

IF THIS SHEET IS NOT 24"x36" , IT IS A REDUCED PRINT – SCALE ACCORDINGLY

0 50 100 150
1" = 50' GRAPHIC SCALE

Revisions

No.	Revisions	By	Date	Appr.
1	REV TCP076,076.1	PM	7/28/22	

BAY-CON INFRASTRUCTURE
PO BOX 1342
SAN MATEO CA 94401
(415) 580-1441 OFFICE
(415) 329-3240 FAX
INFO@BAY-CON.COM

Key Plan

This document is the property of the engineer and is not to be used without engineer's written permission. Satellite imagery provided by Google Earth.

Engineer Of Record:
PHIL MIESZKOWSKI, PE

REGISTERED PROFESSIONAL ENGINEER PHILLIP M. MIESZKOWSKI C76768 EXP. 12/31/2022 CIVIL STATE OF CALIFORNIA

7/28/2022

DESIGN DOCUMENTS
TEMPORARY TRAFFIC CONTROL

Client
MICHAEL O'SHAUGHNESSY CONSTRUCTION, INC
48 RIVERTON DR
SAN FRANCISCO, CA 94132
(415) 726-3052
OFFICE@MOSCONSTRUCTION.ORG

Owner
SAN FRANCISCO PUBLIC WORKS
49 S VAN NESS AVE, SUITE 1600
SAN FRANCISCO, CA 94103
(628) 271-3139
CONTRACTADMIN.STAFF@SFDPW.ORG

Project
VARIOUS LOCATIONS NO. 52 PAVEMENT RENOVATION AND SEWER REPLACEMENT
SAN FRANCISCO, CA
SOURCING ID NO. 0000003758

Sheet Title
TCP FOR CONCRETE STREET RECONSTRUCTION ON PERALTA AVE FROM MULLEN AVE TO FLORIDA ST – EAST SIDE – WORKING AND NON-WORKING HOURS – SHEET 40 OF 53

- [x] NO EXCEPTIONS TAKEN
- [ ] MAKE CORRECTIONS NOTED
- [ ] REJECTED
- [ ] REVISE AND RESUBMIT
- [ ] SUBMIT SPECIFIED ITEM(S)

Review is only for general conformance with the design concept of the project and general compliance with the requirements of the contract documents. Any action shown is subject to the requirements of the plans and specifications. Contractor's responsibilities include, but are not limited to actual dimensions which shall be confirmed and correlated at the job site; preferred fabrication processes and techniques of construction; coordination of the contractor's work with that of all other trades; and the satisfactory performance of the contractor's work.

Sustainable Streets Division
San Francisco Municipal Transportation Agency
City and County of San Francisco

By _____ Date 8/2/22

BCI Job 146
Drwn By PM
Chckd By PM
Issue Date 05/20/2022

Sheet
TCP-076

76, 7/28/2022 11:29:30 AM