Traffic Lane Requirements
Number and Width of Lanes

STREET	TIME	NORTHBOUND	SOUTHBOUND	EASTBOUND	WESTBOUND
GRINDING, PAVING, CONCRETE STREET, & BASE REPAIR WORK					
MULLEN AVENUE					
Alabama St to Peralta St ➡/⬅	8AM – 4PM (M-F)	-	-	1@11' ➡/⬅	
	At Other Times	-	-	Full Rdwy	
Cross Streets for Mullen Ave					
Alabama St	8AM – 4PM (M-F)	1@11'	1@11'	-	-
	At Other Times	Full Rdwy	Full Rdwy	-	-
Peralta St	8AM – 4PM (M-F)	1@10' Reversible↕		-	-
↕	At Other Times	Full Rdwy		-	-

↕ The Contractor shall designate the lane for two-way traffic with flag person at each end of the two-way road segment to control the flow of traffic. This operation shall be restricted to one block at a time.

⬆ The Contractor shall designate the lane for one way traffic heading northbound (or ⬇ southbound, ➡ eastbound, ⬅ westbound) as specified during construction hours only with flag person at each end of the intersection to control the flow of traffic. The Contractor shall set up construction signs according to the approved traffic detour plans as deemed necessary and shall install/remove or cover/uncover the signs on a daily basis. Local access must be maintained at all times.

REPLACE OPEN TRENCH SIGNS WITH SIGNS APPROPRIATE FOR THE WORK ACTIVITY:

C27 OPEN TRENCH — CONCRETE STREET BASE DEMO

C43(CA) FRESH CONCRETE — PLACING CONCRETE STREET BASE

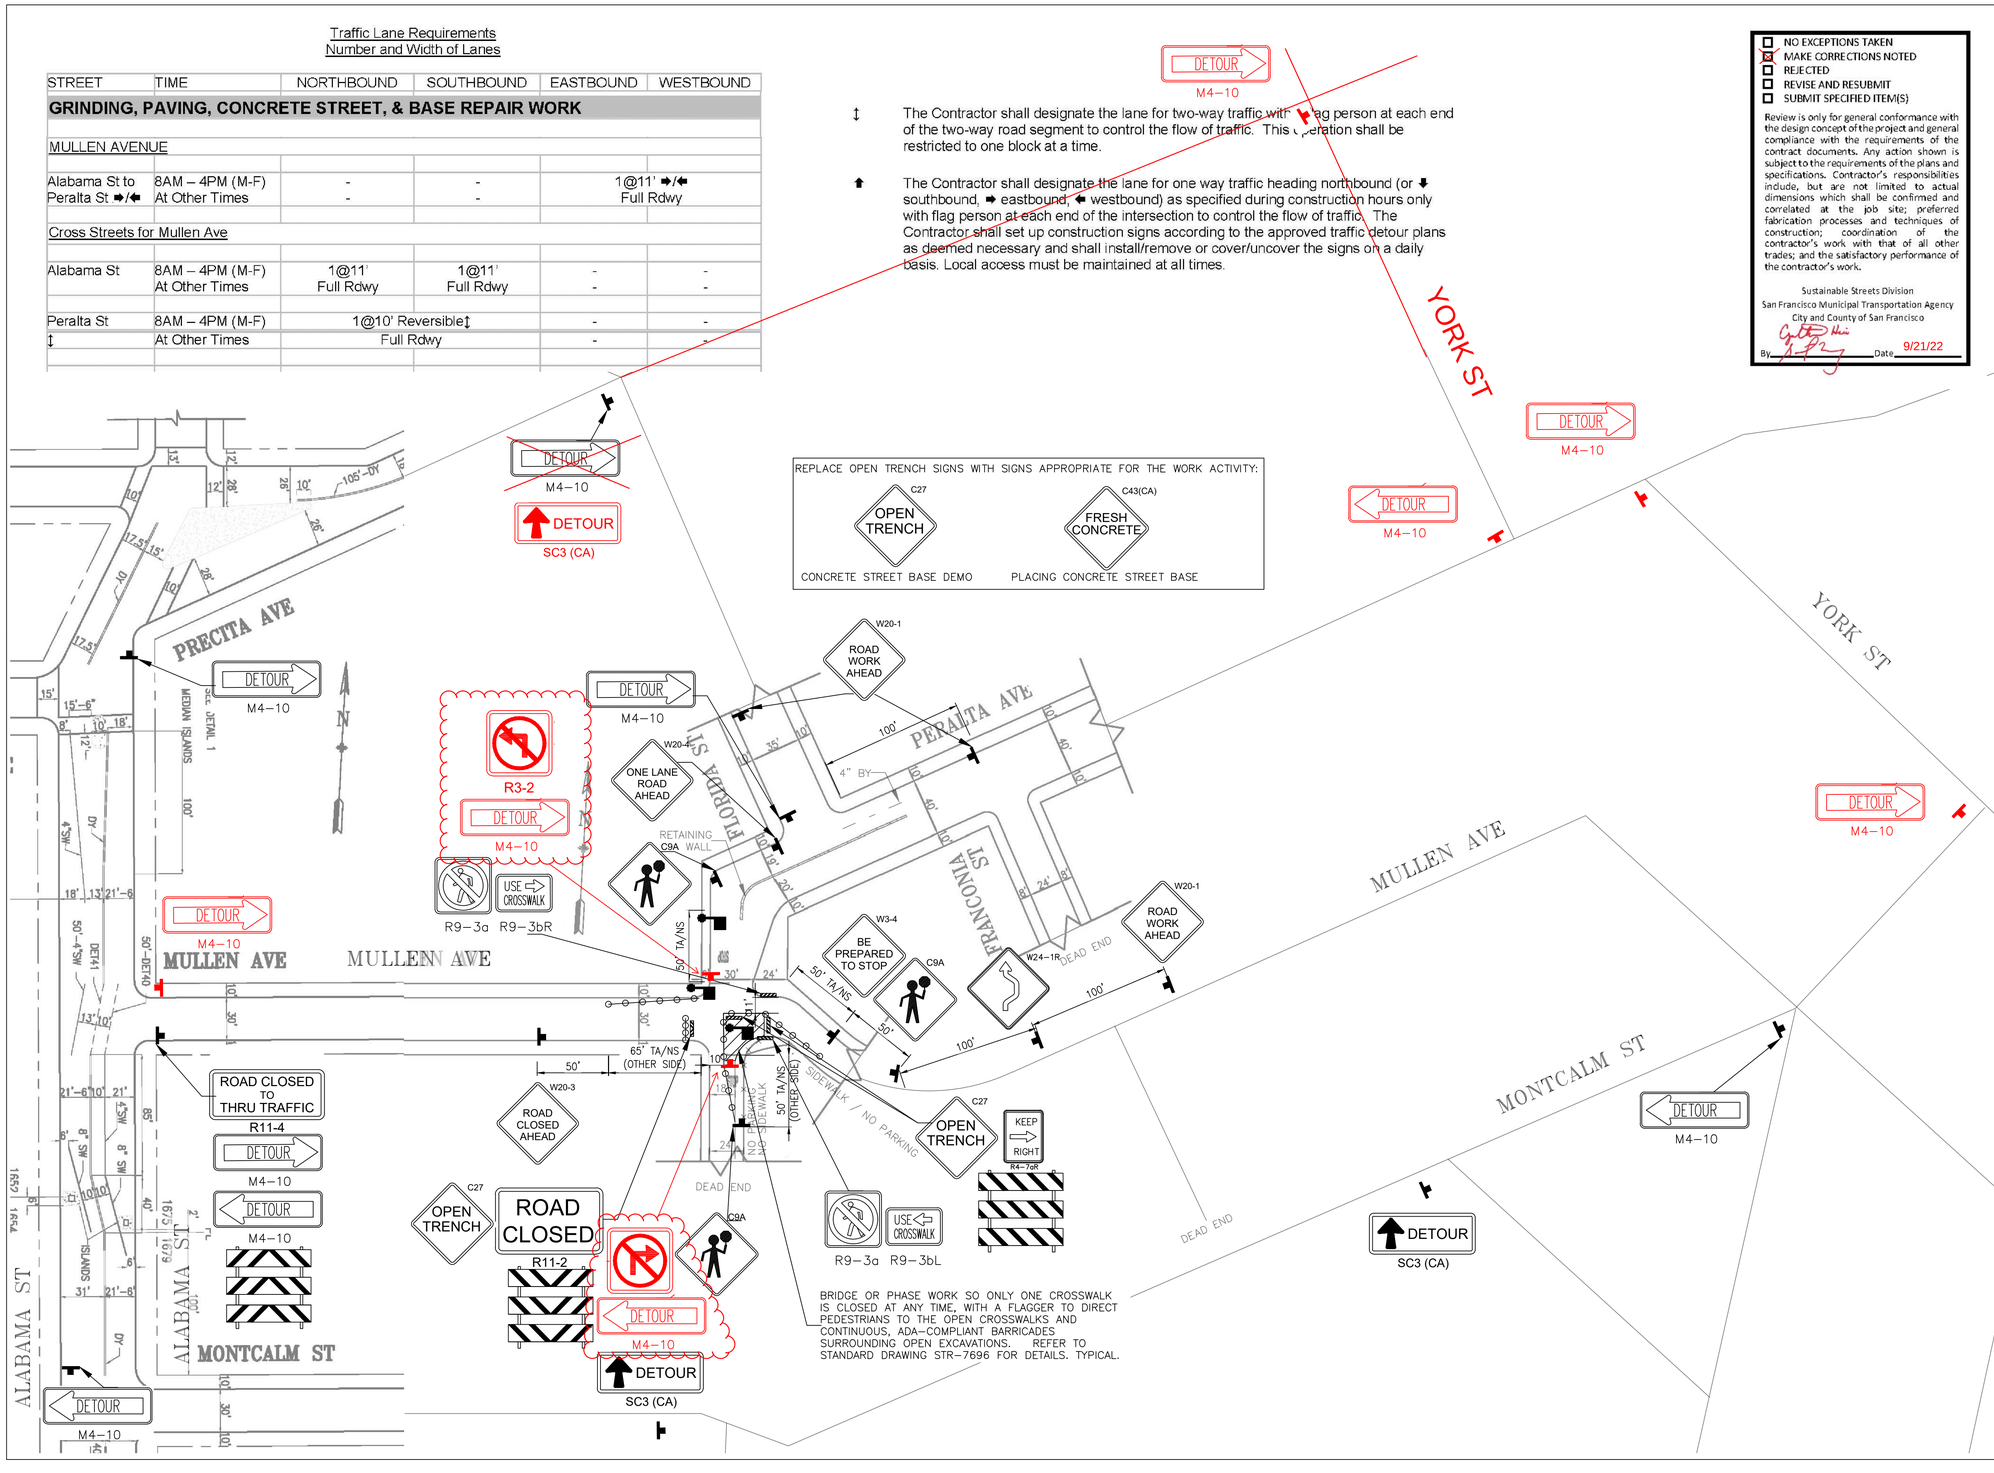

BRIDGE OR PHASE WORK SO ONLY ONE CROSSWALK IS CLOSED AT ANY TIME, WITH A FLAGGER TO DIRECT PEDESTRIANS TO THE OPEN CROSSWALKS AND CONTINUOUS, ADA-COMPLIANT BARRICADES SURROUNDING OPEN EXCAVATIONS. REFER TO STANDARD DRAWING STR-7696 FOR DETAILS. TYPICAL.

☐ NO EXCEPTIONS TAKEN
☒ MAKE CORRECTIONS NOTED
☐ REJECTED
☐ REVISE AND RESUBMIT
☐ SUBMIT SPECIFIED ITEM(S)

Review is only for general conformance with the design concept of the project and general compliance with the requirements of the contract documents. Any action shown is subject to the requirements of the plans and specifications. Contractor's responsibilities include, but are not limited to actual dimensions which shall be confirmed and correlated at the job site; preferred fabrication processes and techniques of construction; coordination of the contractor's work with that of all other trades; and the satisfactory performance of the contractor's work.

Sustainable Streets Division
San Francisco Municipal Transportation Agency
City and County of San Francisco

By _____ Date 9/21/22

IF THIS SHEET IS NOT 24"x36" , IT IS A REDUCED PRINT – SCALE ACCORDINGLY

0 50 100 150
1" = 50' GRAPHIC SCALE

Revisions

No.	Revisions	By	Date	Appr.
1	REV TCP071,050,051	PM	7/12/22	

BAY-CON INFRASTRUCTURE

BAY-CON INFRASTRUCTURE
PO BOX 1342
SAN MATEO CA 94401
(415) 580-1441 OFFICE
(415) 329-3240 FAX
INFO@BAY-CON.COM

Key Plan

This document is the property of the engineer and is not to be used without engineer's written permission. Satellite imagery provided by Google Earth.

Engineer Of Record:
PHIL MIESZKOWSKI, PE

REGISTERED PROFESSIONAL ENGINEER PHILLIP M. MIESZKOWSKI C 76768 EXP. 12/31/2022 CIVIL STATE OF CALIFORNIA

7/12/2022

DESIGN DOCUMENTS
TEMPORARY TRAFFIC CONTROL

Client
MICHAEL O'SHAUGHNESSY CONSTRUCTION, INC
48 RIVERTON DR
SAN FRANCISCO, CA 94132
(415) 726-3052
OFFICE@MOSCONSTRUCTION.ORG

Owner
SAN FRANCISCO PUBLIC WORKS
49 S VAN NESS AVE, SUITE 1600
SAN FRANCISCO, CA 94103
(628) 271-3139
CONTRACTADMIN.STAFF@SFDPW.ORG

Project
VARIOUS LOCATIONS NO. 52 PAVEMENT RENOVATION AND SEWER REPLACEMENT
SAN FRANCISCO, CA
SOURCING ID NO. 0000003758

Sheet Title
TCP FOR CONCRETE STREET BASE REPAIR ON MULLEN AVE AT PERALTA AVE – SE QUADRANT – SHEET 35 OF 52

BCI Job 146
Drwn By PM
Chckd By PM
Issue Date 05/20/2022

Sheet
TCP-071

71, 7/12/2022 12:38:09 PM