Traffic Lane Requirements
Number and Width of Lanes

STREET	TIME	NORTHBOUND	SOUTHBOUND	EASTBOUND	WESTBOUND
SEWER MAIN WORK					
MULLEN AVENUE					
Alabama St to Peralta St ©	8AM – 4PM (M-F)	-	-	Closed©	Closed©
	At Other Times	-	-	Full Rdwy	Full Rdwy
Cross Streets for Mullen Ave					
Alabama St	8AM – 4PM (M-F)	1@11'	1@11'	-	-
	At Other Times	Full Rdwy	Full Rdwy	-	-
Peralta St ‡	8AM – 4PM (M-F)	1@10' Reversible‡		-	-
	At Other Times	Full Rdwy		-	-

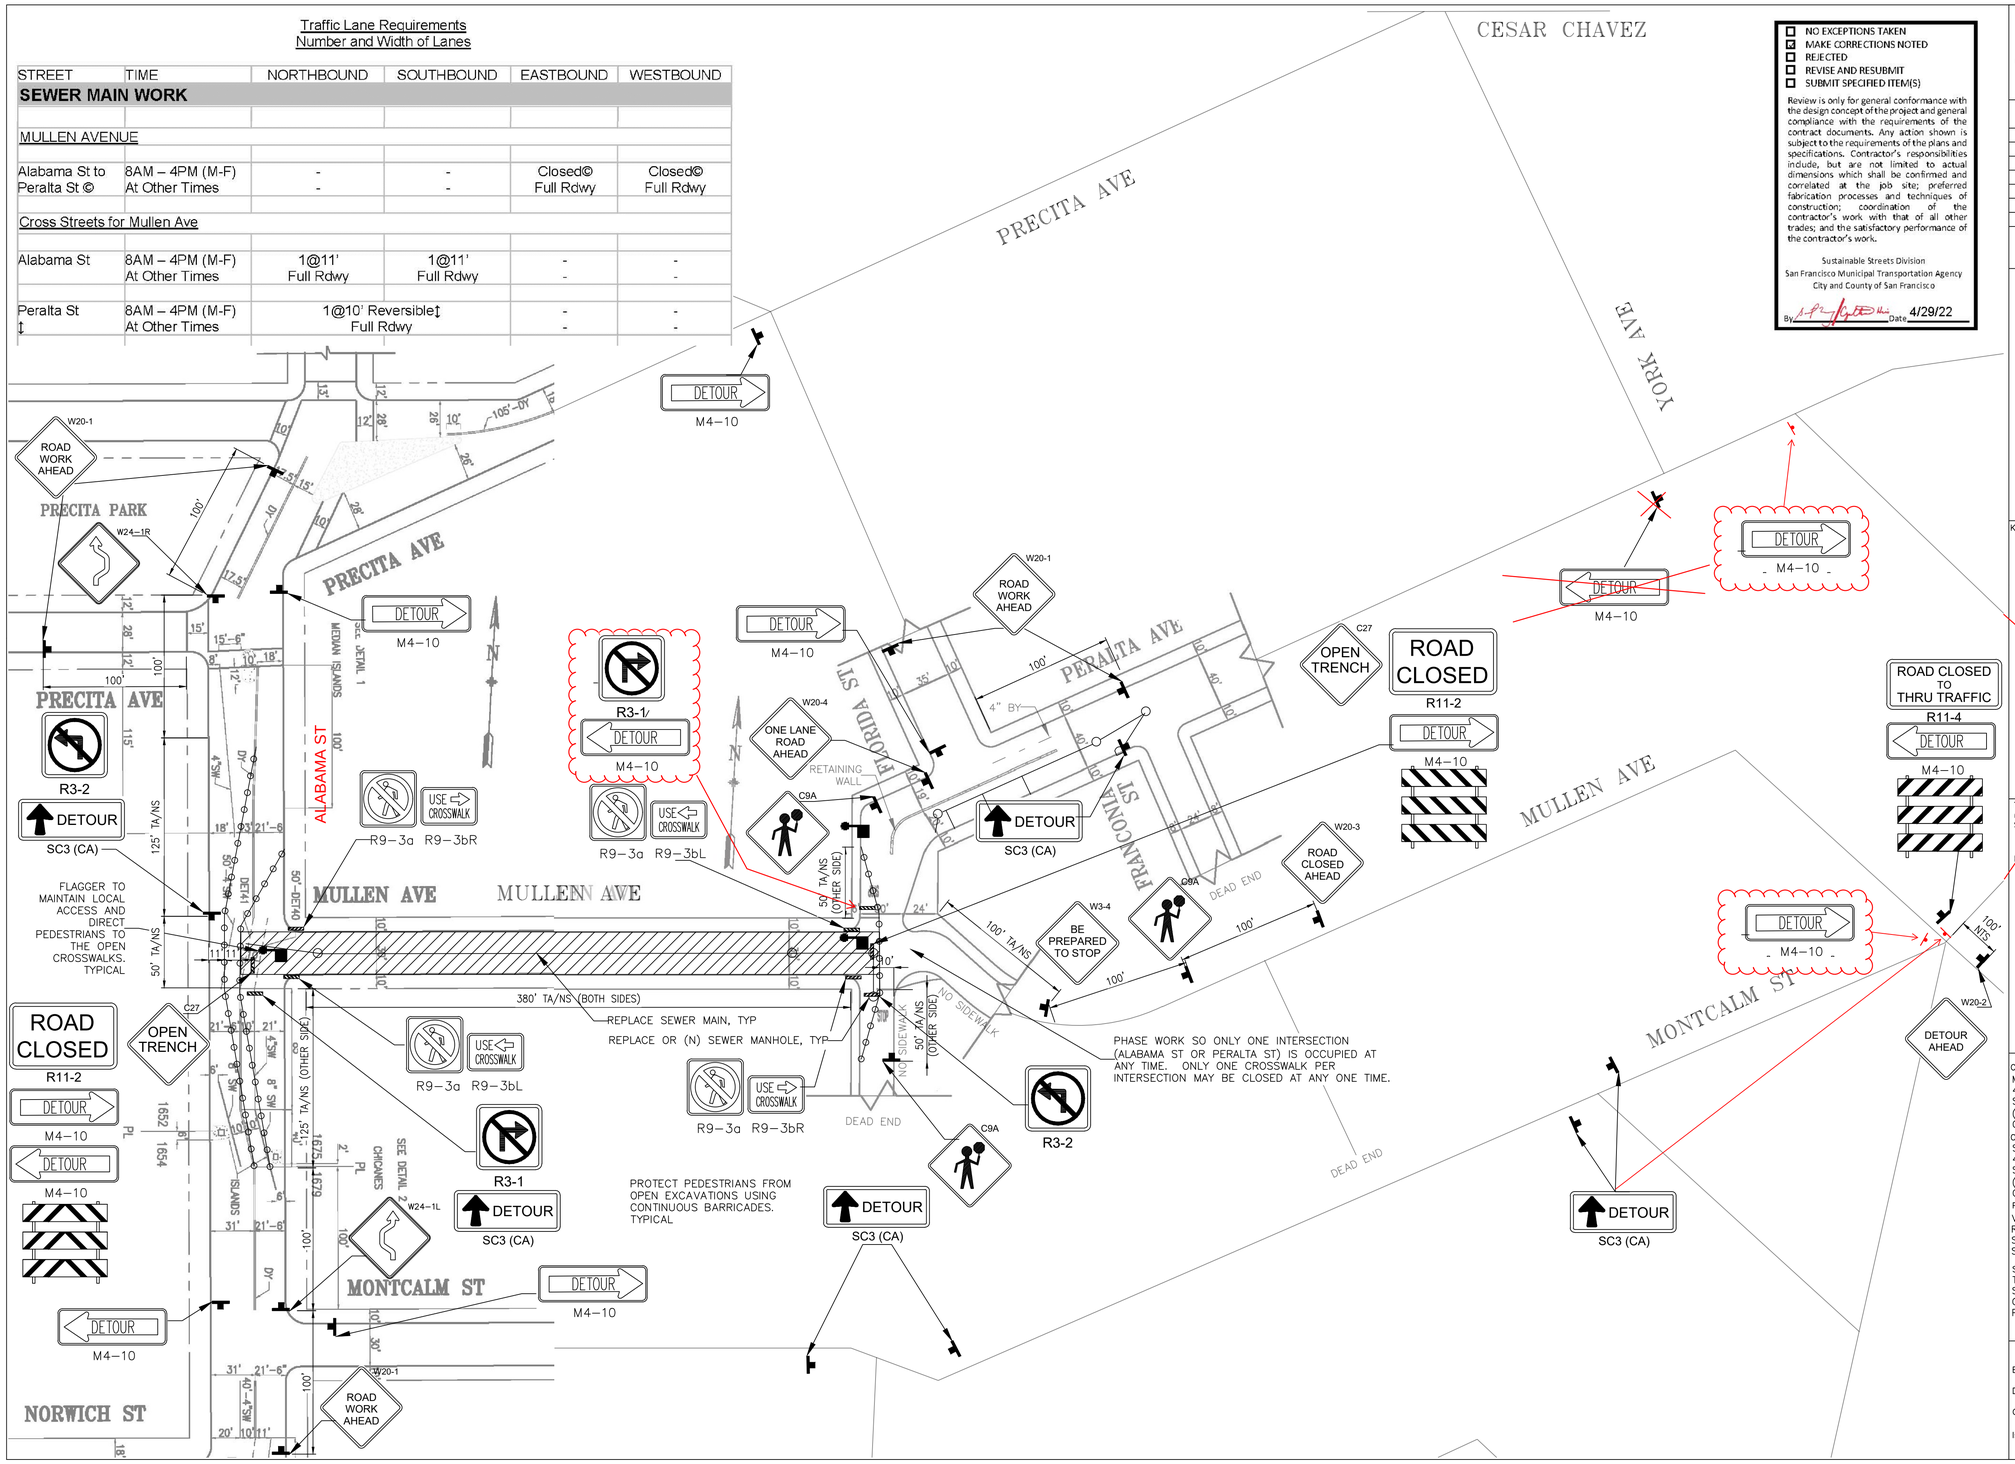

NO EXCEPTIONS TAKEN
MAKE CORRECTIONS NOTED
REJECTED
REVISE AND RESUBMIT
SUBMIT SPECIFIED ITEM(S)

Review is only for general conformance with the design concept of the project and general compliance with the requirements of the contract documents. Any action shown is subject to the requirements of the plans and specifications. Contractor's responsibilities include, but are not limited to actual dimensions which shall be confirmed and correlated at the job site; preferred fabrication processes and techniques of construction; coordination of the contractor's work with that of all other trades; and the satisfactory performance of the contractor's work.

Sustainable Streets Division
San Francisco Municipal Transportation Agency
City and County of San Francisco

By _____ Date 4/29/22

IF THIS SHEET IS NOT 24"x36" , IT IS A REDUCED PRINT – SCALE ACCORDINGLY

0 50 100 150
1" = 50' GRAPHIC SCALE

Revisions

No.	Revisions	By	Date	Appr.

BAY-CON INFRASTRUCTURE

BAY–CON INFRASTRUCTURE
PO BOX 1342
SAN MATEO CA 94401
(415) 580–1441 OFFICE
(415) 329–3240 FAX
INFO@BAY–CON.COM

Key Plan

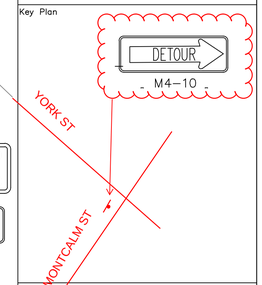

This document is the property of the engineer and is not to be used without engineer's written permission. Satellite imagery provided by Google Earth.

Engineer Of Record:
PHIL MIESZKOWSKI, PE

REGISTERED PROFESSIONAL ENGINEER PHILLIP M. MIESZKOWSKI C 76768 EXP. 12/31/2022 CIVIL STATE OF CALIFORNIA

3/14/2022

DESIGN DOCUMENTS
TEMPORARY TRAFFIC CONTROL

Client
MICHAEL O'SHAUGHNESSY CONSTRUCTION, INC
48 RIVERTON DR
SAN FRANCISCO, CA 94132
(415) 726–3052
OFFICE@MOSCONSTRUCTION.ORG

Owner
SAN FRANCISCO PUBLIC WORKS
49 S VAN NESS AVE, SUITE 1600
SAN FRANCISCO, CA 94103
(628) 271–3139
CONTRACTADMIN.STAFF@SFDPW.ORG

Project
VARIOUS LOCATIONS NO. 52 PAVEMENT RENOVATION AND SEWER REPLACEMENT
SAN FRANCISCO, CA
SOURCING ID NO. 0000003758

Sheet Title
TEMPORARY TRAFFIC CONTROL PLAN FOR SEWER MAIN AND MANHOLE CONSTRUCTION ON MULLEN AVE FROM ALABAMA ST TO PERALTA ST

BCI Job 146
Drwn By PM
Chckd By PM
Issue Date 3/14/2022

Sheet
TCP–022

22, 3/14/2022 3:39:10 PM